

Harvey

Stafford Harvey

KANSAS

KANSAS

Map No. 39 Sec. 20 Twp. 23 R. 3WMap No. 39 Sec. 20 Twp. 23 R. 3WWell No. 1 HullmanWell No. 1 Hullman

Nat'l Assoc. Pet. _____ Company

National Assoc. Pet. _____ Company

FIRST REPORT _____ Contractor

COMPLETED _____ Contractor

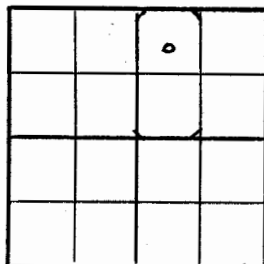
C NW NE

SECTION PLAT

660 Ft. from N. Line

_____ Ft. from S. Line

_____ Ft. from E. Line

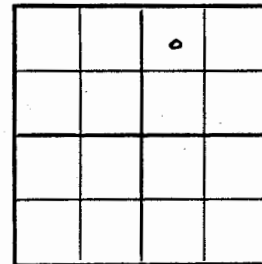
660 Ft. from W. Line660 Ft. from N. Line

_____ Ft. from S. Line

_____ Ft. from E. Line

660 Ft. from W. Line

SECTION PLAT



Burrton Pool

Burrton Pool

Location X

RECORD

Cased _____ in., _____ ft.

Sand _____

Gas _____

Oil _____

Total Depth _____

PRODUCTION

1st 24 hrs. Nat. _____

1st 24 hrs. after shot _____

Gas _____ Cu. Ft.

Dry Hole _____

Abandoned _____

Date

Location _____

RECORD

Cased _____ in., _____ ft.

Sand _____

Gas _____

Oil _____

Total Depth 3327

PRODUCTION

1st 24 hrs. Nat. _____

1st 24 hrs. after shot _____

Gas _____ Cu. Ft.

Dry Hole _____

Abandoned _____

Date

OCT 20 1943

19

S. J. LEWIS Scout

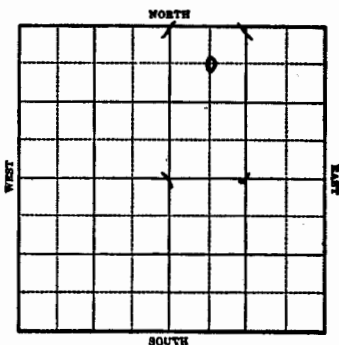
DEC 8 1943

19

S. J. LEWIS Scout

Sec. 20 Twp. 23 R. 3-WWell No. #1 Hullman Farm

Nat'l Assoc. Pets Company

660 Ft. from N. Line Ft. from S. Line Ft. from E. Line660 Ft. from W. Line

1943 REPORT

10/20 Location
10/27 Surface hole
11/3 10" @ 275
Lens 2530
T.D. 2606 fag.
11/10 Miss 3317
T.D. 3332
Run 5"
11/17 5" @ 3315
RUST
11/24 TD 3367'
1000 Acid CØ
12/1 TD 3377
PB 3330 10 qts 3320-30
46 shots 3283-95
24 shots 3272-78
12/8 5" @ 3315
Miss 3358
T.D. 3377
PB 3330
4000 acid 10 qts
1M gas
Flow 5 oil in 24 hrs
Gravity 36.2

COMPLETED

Section 20 Township 23 Range 3-WWell No. #1 HullmanCompany Nat'l Assoc. Pet.