

Map No. KANSAS Sec. 3

Twp. 23 R. 1 W

Well No. Mc

Farm

Prouty
McCollough et al Company

NORTH

WEST

EAST

SOUTH

Location

Drilling Remarks

Rig Up

Drilling Remarks

RECORD

Cased _____ in. _____ ft.

Sand _____

Gas _____

Oil _____

Total Depth _____

PRODUCTION

1st 24 hrs. Nat. _____

1st 24 hrs. after shot _____

Gas _____ cu. ft.

Dry Hole _____

Abandoned _____


Harvey
 Map No. **KANSAS** Sec. 3 Twp. 23 R. 1^w
 Well No. 1 - Prouty Farm
M^c Pullough et al Company

330 Ft. from N. Line

_____ Ft. from S. Line

_____ Ft. from E. Line

330 Ft. from W. Line

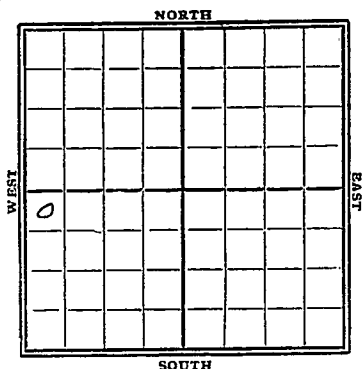

Date

REPORT

4/17	Location
4/24	Rig
5/1	Rigging up
5/8	Rigged up - S.D.
5/15	S.D. 300'
5/22	Rig up
5/29	Wrlg 358
6/5	" 1010
6/11	" 1300
6/19	" 1925'
6/26	Log tools 2020
7/2	S.D. 2020
7/10	— 9/18 —
7/17	— 9/25 - Run 10" - 2020
7/24	— 10/2 - Wrlg 2370'
7/31	— 10/8 - " 2480'
8/7	— 10/16 - Log tools
8/14	— 10/23 —
8/21	— (over)
8/28	—
9/4	—
9/11	—

10/30 - Dry by tools 2480'
11/6 - " 2572'
11/13 - " 2703
11/20 - " 2857
11/27 - " 3042
12/4 - Top Unit 3065 HFW 3120
dry 3160
12/11 - Baseline 3360
dry 3380
12/18 - Top Viola 3423
HFW 3455-60'
S.D. 3501' T.D.
12/23 —
12/30 - S.D. 3501' T.D.
1930
1/8 - T.D. 3504'
Dry & Abandoned

Map No. KANSAS Sec. 8 Twp. 23 R. 1W

Well No. 1 Procty

McCullough et al. Company

Contractor

SECTION PLAT

320 Ft. from N. Line

..... Ft. from S. Line

..... Ft. from E. Line

320 Ft. from W. Line

0			

FIRST REPORTS

Location ✓

Rig up

Drilling and Remarks:

RECORD

Cased in., ft.

Sand

Gas

Oil

Total Depth

PRODUCTION

1st 24 hrs. Nat.

1st 24 hrs. after shot

Gas Cu. Ft.

Dry Hole

Abandoned

Date

APR 17 1929

S. J. LEWIS

Scout

Map No. 39 KANSAS Sec. 3 Twp. 23 R. 14

Well No. 1 County

McCullough & Co. Company

Contractor

SECTION PLAT

330 Ft. from N. Line

..... Ft. from S. Line

..... Ft. from E. Line

330 Ft. from W. Line

ABANDONED

0			

Location.....

Rig up.....

Drilling and Remarks:

RECORD

Cased.....in.,ft.

Sand.....

Gas.....

Oil.....

Total Depth.....3504

PRODUCTION

1st 24 hrs. Nat.....

1st 24 hrs. after shot.....

Gas.....Cu. Ft.

Dry Hole.....

Abandoned.....

Date

JAN 8 1930

S. J. LEWIS Scout