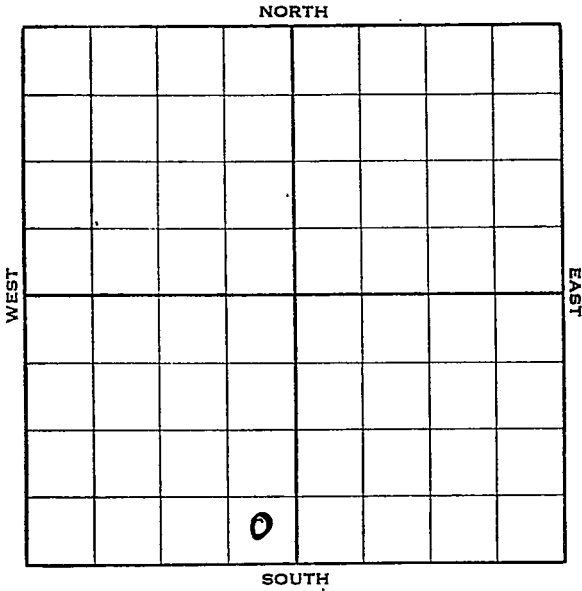


Reno

Section 3 Township 23 Range 5-WWell No. 1 DurandCompany L. E. Douglas et al

KANSAS

Reno

Sec. 3 Twp. 23 R. 5-W

Well No. #1 Durand Farm


L. E. Douglas et al Company

_____ Ft. from N. Line

330 Ft. from S. Line

330 Ft. from E. Line

Ft. from W. Line

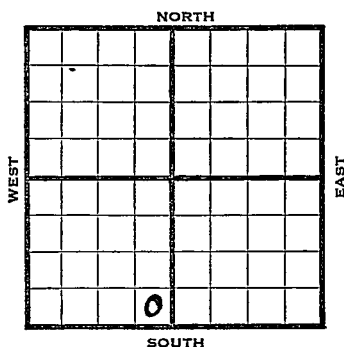

Elev. 1531

1938

REPORT

5 / 25

16" @ 203'.

Dr1g. 220'.

6/3

Drlg. 2570'.

6/10

SD 3073!.

Rebuilding rig.

6/17

Dr lg. 3600'.

6/22

K. C. 28241.

Miss: 34531:

Simp. 3929!.

Arb. 40061.

T.D. 40241.

No oil.

ABANDONED

Reno KANSAS

Map No. 40 Sec. 3 Twp. 23 R. 5WWell No. 1 DurandL. E. Douglas et al Company

Contractor

FIRST REPORT

SE SW

 Ft. from N. Line330 Ft. from S. Line330 Ft. from E. Line Ft. from W. Line

SECTION PLAT

Location Rig up

Drilling and Remarks:

16"-203Dr1g. 220

RECORD

Cased in., ft.Sand Gas Oil Total Depth

PRODUCTION

1st 24 hrs. Nat. 1st 24 hrs. after shot Gas Cu. Ft.Dry Hole Abandoned

Date

MAY 25 1938 19 H. D. Hatfield Scout

Reno

KANSAS

Map No.

40

Sec.

3

Twp.

23

R.

SW

Well No. 1 Durand

L. E. Douglass et al

Company

Contractor

ABANDONED

SE SW

Ft. from N. Line

330

Ft. from S. Line

330

Ft. from E. Line

Ft. from W. Line

SECTION PLAT

	0		

Location

Rig up

Drilling and Remarks:

K.C. 2824

MISS 3453

Simp. 3929

Arb 4006

T.D. 4024

NO oil

DVA

RECORD

Cased _____ in., _____ ft.

Sand _____

Gas _____

Oil _____

Total Depth 4024

PRODUCTION

1st 24 hrs. Nat. _____

1st 24 hrs. after shot _____

Gas _____ Cu. Ft.

Dry Hole _____

Abandoned _____

Date

JUN 22 1938

19

H. D. Hatfield

Scout