

Section 3 Township 23 Range 11 WWell No. # 1 KrugCompany Lewis Drlg.

NORTH

							0

WEST

EAST

SOUTH

Stafford

KANSAS

Sec. 3 Twp. 23 R. 11W

Well No. #1 Krug "A" Farm ✓

Lewis Drlg. Company

Lewis - Contr. Contractor


Wildcat

 Ft. from N. Line

330' Ft. from S. Line

330' Ft. from E. Line

 Ft. from W. Line

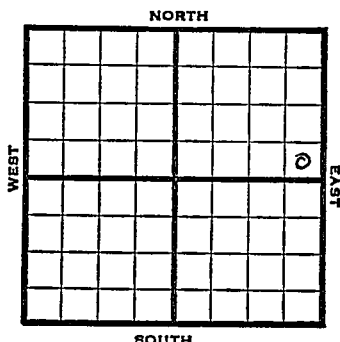

SE SE NE


1951 Elev. 1789' REPORT

12/19 Spd 12-14-51
8" @ 184
Anhy 510
Drlg. 1859'

1952
1/2 Spud 12-14-51
D & A TD 3735' 8" @ 184'
Anhy 510' Heeb 3103' Br. line 3243'
Lans. 3268' Viola 3610' Simp. 3648'
Arb. 3706'
TD 3735' D & A

ABANDONED


County Stafford State Kansas
 Sec. 3 (Blk. 23) (Sur. 11W) Map No. 11W
 Operator Lewis D. lg.
 Well No. 1 Farm Krug
 Elev. _____ Location SE SE NE

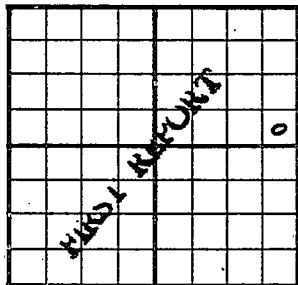

330 Ft. From S Line NE
330 Ft. From E Line Quarter
 Ist. Report DEC 1 9 1951
 Completion _____
 Remarks _____
Lewis Drig. - Contr.
 Spudding Date 12-14-51

Drig. Data Wildcat
8" @ 184' Anhy 510 Drig. 1859

J. E. TYRA

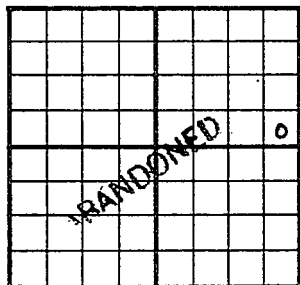County Stafford State KansasSec. 3 (Blk. Twp.) 23 (Sur. Rge.) 11W Map No.Operator Lewis Drlg.Well No. 1 Farm Krug "A"Elev. 1789 Location SE SE NE330 Ft. From S Line NE330 Ft. From E Line Quarter

1st. Report

Completion JAN 2 1952Remarks WildcatLewis Drlg. - Contr.Spudding Date 12-14-51Drlg. Data D & A TD 37358" @ 184 Anhy 510 Heeb. 3103Br. lime 3243 Lans. 3268 Viola 3610Simp. 3648 Arb. 3706 TD 3735D & A

J. E. TYRA