


Section 3 Township 23 Range 12W

Well No. #1 Dale

Company Shields & Armer

Wildcat

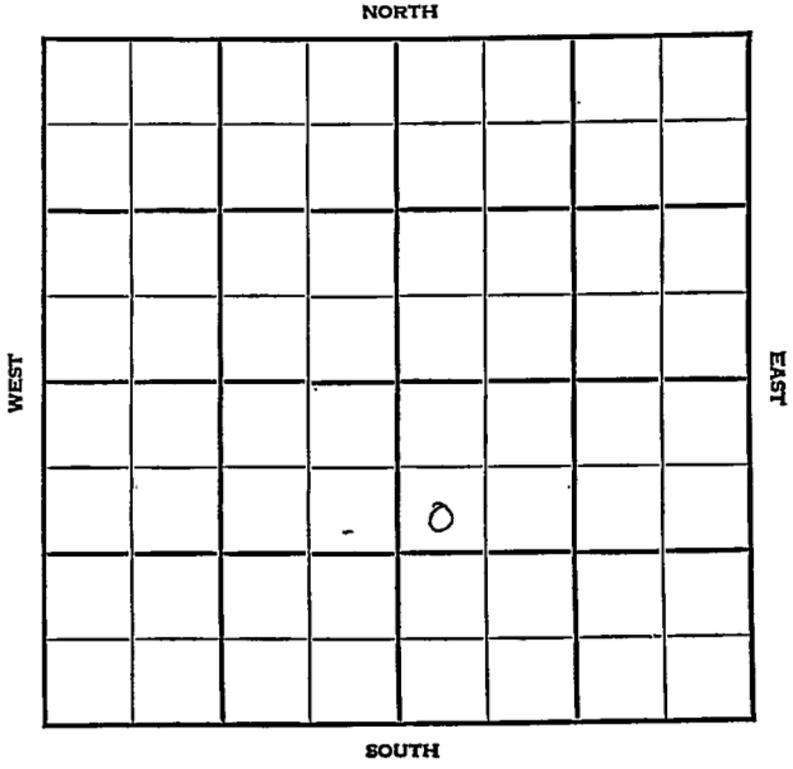

Sec. 3 Twp. 23 R. 12W

Well No. #1 Dale Farm

Shields & Armer Company

Wildcat


NORTH

990' Ft. from N. Line

_____ Ft. from S. Line

_____ Ft. from E. Line

330' Ft. from W. Line

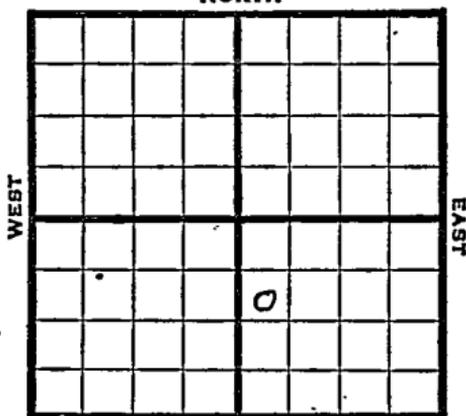

SOUTH

SW NW SE

1948

Elev. 1834' REPORT

2/18 Location

2/25 8" @ 240'
WOC

3/3 Drlg. 2425'

3/10 Lansing 3304'
BKC 3556'
Viola 3639'
Drlg. 3648'

3/17 Arb. 3768'
TD 3820'

ABANDONED

Map No. _____ Sec. 3 Twp. 23 R. 12W

Well No. 1 Dale _____

Shields & Armer _____ Company

FIRST REPORT _____ Contractor

SW NW SE


SECTION PLAT

990 Ft. from N. Line

_____ Ft. from S. Line

_____ Ft. from E. Line

330 Ft. from W. Line

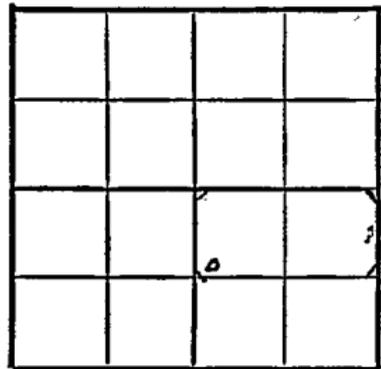

Stafford County

Location X

Rig up _____

Drilling and Remarks:

RECORD

Cased _____ in., _____ ft.

Sand _____

Gas _____

Oil _____

Total Depth _____

PRODUCTION

1st 24 hrs. Nat. _____

1st 24 hrs. after shot _____

Gas _____ Cu. Ft.

Dry Hole _____

Abandoned _____

Date

FEB 18 1948 19

S I LEWIS Scout

Map No. 47 Sec. 3 Twp. 23 R. 12W

Well No. 1 Dale

Shields & Armer Company

ABANDONED Contractor

SW NW SE

E 11834
SECTION PLAT

990 Ft. from N. Line

 Ft. from S. Line

 Ft. from E. Line

330 Ft. from W. Line

Stafford County

Location

Rig up

Drilling and Remarks:

Per 18768

RECORD

Cased in., ft.

Sand

Gas

Oil

Total Depth 3820

PRODUCTION

1st 24 hrs. Nat.

1st 24 hrs. after shot

Gas Cu. Ft.

Dry Hole

Abandoned

Date

MAR 17 1948 19

S. J. LEWIS Scout