


SECTION 3 TOWNSHIP 23S RANGE 11W

WELL NO. #1 Asher

COMPANY Coppinger

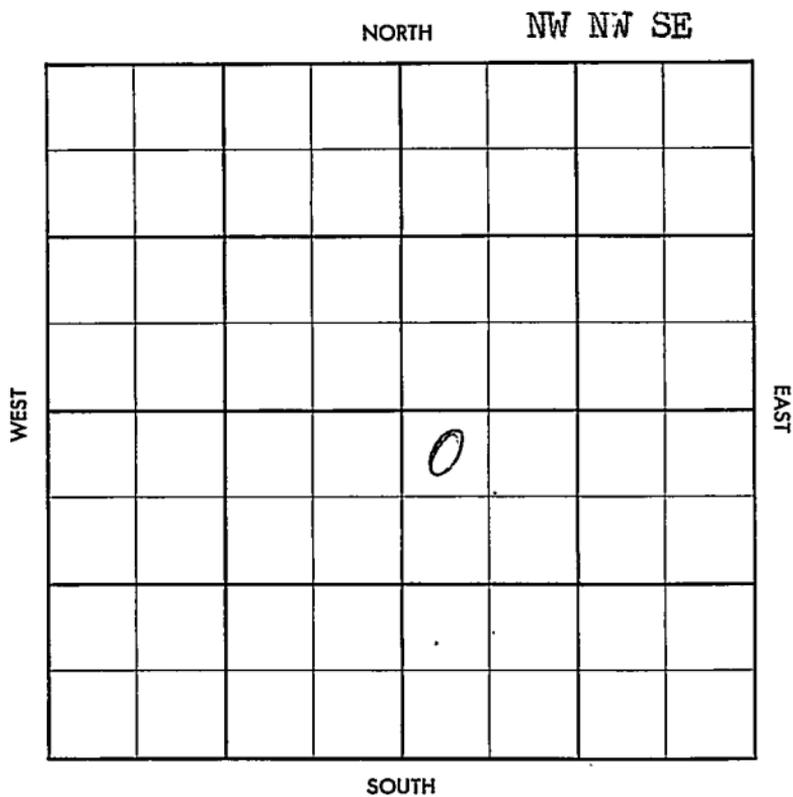

13

FORM 513 SUNRAY

County Starford Elev. \_\_\_\_\_  
 Sec. 3 Twp. 23 Rge. 14W  
 Company Coppinger  
 FarmName Asher No. 1

Co.

TOPS	DEPTH	LOG	DATUM
Anh.			
Tp.			
H.			
Tr.			
Dg.			
Bl.			
L.			
K.C.			
B.K.C.			
Ce.			
C.			
M.			
M.			
K.			
Mz.			
Me.			
V.			
S.			
S.			
A.			
R.			
Pe.			
G.			
T.D.			

Loc. in Sec. NW NW SE

Geol. \_\_\_\_\_

Contr. \_\_\_\_\_

Rev & Morris

Pool \_\_\_\_\_

Green Valley


**FIRST REPORT**  
 SEP 17 1937

L.S.R.

No.

Date Comm. A merada - DHM  
 Location \_\_\_\_\_

Sec.

T.

R.

Co.  
Lsg.  
No.  
Sec.  
T.  
R.

County Stafford Elev. \_\_\_\_\_  
 Sec. 3 Twp. (23) Rge. 11W  
 Company Coppinger  
 FarmName Asher No. 1

TOPS	DEPTH	LOG	DATUM
Anh.	860		
Tr.			
H.		3388	
Tr.		3407	
Dg.			
Bl.		3522	
L.		3537	
K.C.			
B.K.C.	3557	3558	
Ce.			
C.			
M.			
M.			
K.			
Mz.			
Ma.			
V.		3857	
S.	3902	3898	
S.			
A.	3951	3952	
R.			
PE.			
G.			
TD.	3986		

Loc. in Sec. NW NW SE  
 Geol. \_\_\_\_\_  
 Contr. \_\_\_\_\_  
 Rex & Morris  
 Pool  
 Green Valley

ABANDONED	
SEP 25 '57	

Date Comm. TEXAS Sicelly A merada - DFM  
 Location APD 18 57 9-13-57 8" 388/250  
2760 SEP 57 DSI 3895-3906  
14 15' SO CM BHP 27

V & A