


Section 3 Township 23 Range 14 W

Well No. # 1 Allander

Company Westgate-Greenland

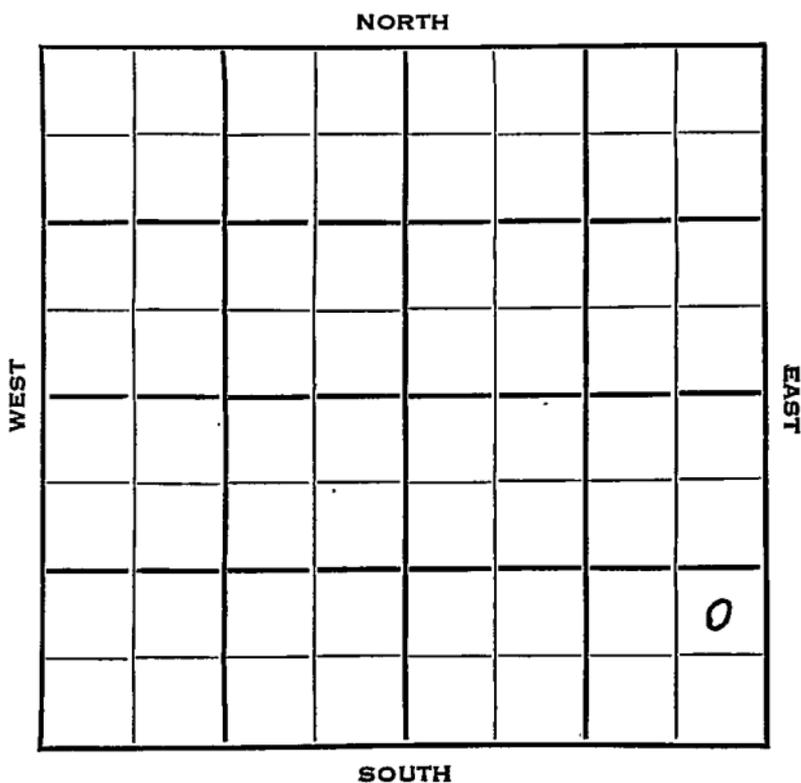

Sec. 3 Twp. 23 R. 14W

Well No. #1 Allander Farm

Westgate-Greenland Company

W-G Contractor

Green Valley Pool


\_\_\_\_\_ Ft. from N. Line

990 Ft. from S. Line

330 Ft. from E. Line

\_\_\_\_\_ Ft. from W. Line

NE SE SE

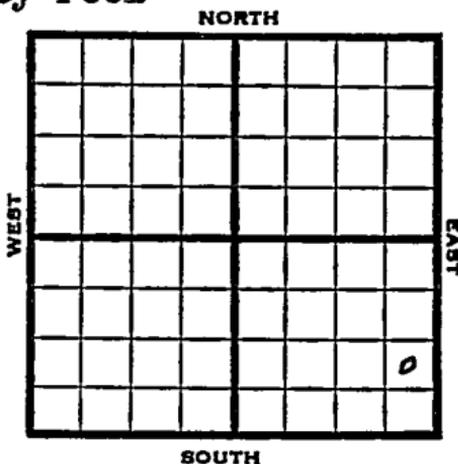

1953

Elev. 1951' REPORT

6/3 Spud 5-27-53  
10" @ 204'  
Anhy 850'  
Drlg 2275'

6/10 Drlg. 3951'

6/24 NR

7/15 Spud 5-27-53  
Oil Well  
TD 3990  
10" @ 204'  
Anhy 850, Heeb 3374, Br lime 3505,  
Lans 3521  
DST 3632-50, opn 1 hr., rec. 75' o&gcm  
120' mco, 430#  
B KC 3746, Viola 3833, Simp 3889,  
Arb. 3940  
DST 3942-49, opn 1hr., rec. 248'  
ocm & sul wtr., 60' sul wtr., 1140#  
~~XXX#XX~~  
TD 3990  
7" @ 3989, CO to TD  
48/3640-46, 1000A, S/4 bo 1 bwph  
Comp. 55 bopd 40% wtr.

COMPLETED



