

Pawnee

DX 78-1


KANSAS

Section 3 Township 23 Range 16W

Well No. #5 Aldrich

Company G-M-R Oil

NORTH

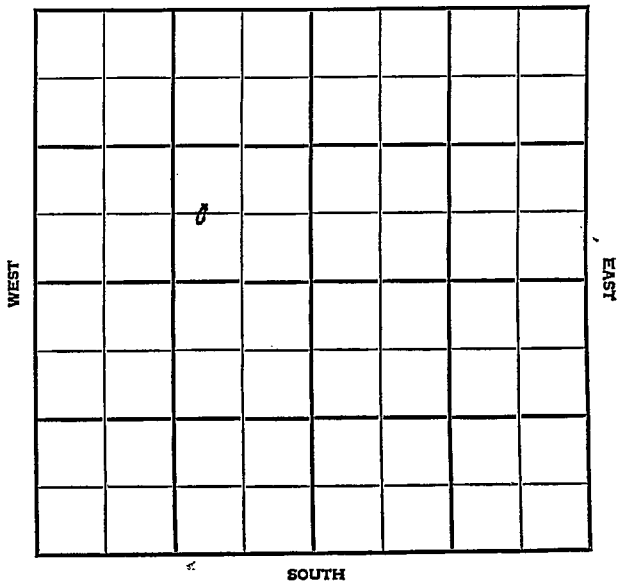

Pawnee

KANSAS

SEC.	TWP.	R.
3	23	16W

WELL NO.

#5 Aldrich

FARM

COMPANY

G-M-R Oil

CONTRACTOR

Co. Tools.

SW Shady Pool

Ft. from N. Line


660

Ft. from S. Line

990

Ft. from E. Line

Ft. from W. Line

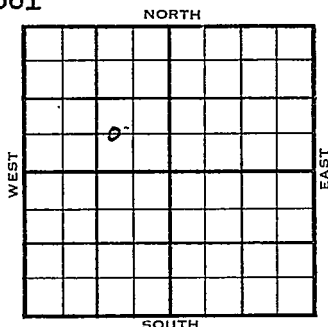C $W\frac{1}{2}$ SE NW

	ELEVATION	REPORT
1954	2048'	
11/11	M I R	
12/8	Spud 11-9-54 - Gas Well	
	TD 4115'	
	8-5/8" @ 225'	
	Br. lime 3630', Lans. 3641'	
	DST 3633-83', opn 1 hr., rec. 165'	
	GCM,	
	Cong. 4001'	
	DST 3993-4041', opn 1 hr., gas in 3",	
	396,000 CFG in 5", 887,000 CFG in 1 hr.	
	1245#	
	DST 4043-75', opn 1 hr., rec. 35' mud,	
	0#	
	Simp. 4079', Arb. 4110'	
	TD 4115'	
	5" @ 4113'	
	CO to 4115'	
	600,000 cfg, 1000A	
	Comp. 2,830,000 cfgpd	

COMPLETED

County **Pawnee** State **Kansas**

Sec. **3** (Blk. Twp.) **23** (Sur. Rge.) **16W** Map No.

Operator **G-M-R Oil**

Well No. **5** Farm **Aldrich**

Elev.	Location	C W ₂ ¹ SE NW
-------	----------	-------------------------------------

2

FIRST REPORT

660 Ft. From S Line NW

990 Ft. From E Line Quarter

1st. Report NOV 10 1954

Completion

Remarks

Co. tools

Spudding Date _____

Drig. Data SW Shady Pool

M I R


FABEN GILSTRAP

County Pawnee State Kansas
 Sec. 3 (Blk.) 23 (Sur.) 16W Map No.

Operator G-M-R Oil

Well No. 5 Farm Aldrich

Elev. 2048 Location C W $\frac{1}{2}$ SE NW

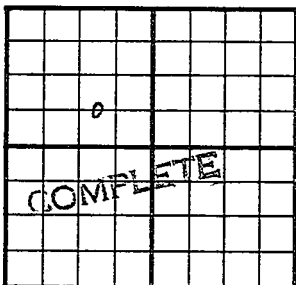

660 Ft. From S Line NW

990 Ft. From E Line Quarter

1st. Report

Completion DEC 8 1954

Remarks SW Shady Pool

Co. tools

Spudding Date 11-9-54

Drlg. Data Gas well TD 4115

8 5/8" @ 225 Br. lime 3630 Lans. 3641

DST 3633-83 open 1 hr. Rec. 165' gom

Cong. 4001 DST 3993-4041 open 1 hr.

gas in 3min. 396,000 cfg in 5 min.

887,000 cfg in 1 hr. 1245#

DST 4043-75 open 1 hr. Rec. 35' mud

0# Simp. 4079 Arb. 4110 TD 4115

5" @ 4113 CO to 4115 600,000:cfg

1000 A Comp. 2,830,000 cfcpd

FABEN GILSTRAP