


Section 3 Township 23 Range 16WWell No. 2 #1 Aldrich "A"Company G-M-R Oil

NORTH

WEST

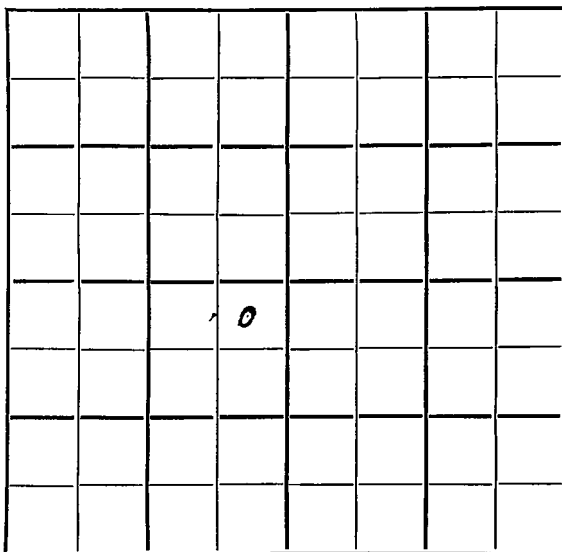

EAST

SOUTH

Pawnee KANSAS

SEC.	TWP.	R.
3	23	16W

WELL NO. #2 Aldrich "A" FARM

COMPANY G-M-R Oil

CONTRACTOR G-M-R


SW Shadey Pool

330 Ft. from N. Line

Ft. from S. Line

330 Ft. from E. Line

Ft. from W. Line

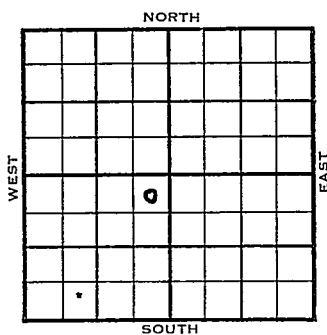

NE NE SW

1954	ELEVATION	REPORT
	2050'	

4/14 Spud 4-12-54
8" @ 428' WOC

6/9 Spud 4-12-54
Oil Well
TD 4087'
8" @ 428'
Anhy 1005', Br lime 3609', Lans 3617'
DST 3612-44', opn 1 hr., rec. 60' VSOCM
1170#
DST 3647-62', opn 2 hrs., oil in 58",
1120#
DST 3746-70', opn 1 hr., rec. 134'
mcw, 1240#
Cong 3985', Simp. 4062', Arb. 4081',
TD 4087'
5" @ 4084'
13/3707-11, S/3½ boph 10% wtr.
SP 3680', 23/3648-56, 2000A
S&F 40 boph 9 hrs.
Comp. 2254 bopd

COMPLETED

J. G. McGEHEE

Kansas

Map No. _____ Sec. 3 Twp. 23 R. 16W

Well No. 2 Aldrich "A"

G-M-R Oil Company

CORRECTION Contractor

NE NE SW


SECTION PLAT

330 Ft. from N. Line

_____ Ft. from S. Line

330 Ft. from E. Line

_____ Ft. from W. Line

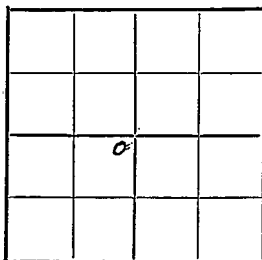

Pawnee County

Location _____

Rig up _____

Drilling and Remarks:

Reported
#1 Aldrich "A"

RECORD

Cased _____ in., _____ ft.

Sand _____

Gas _____

Oil _____

Total Depth _____

PRODUCTION

1st 24 hrs. Nat. _____

1st 24 hrs. after shot _____

Gas _____ Cu. Ft.

Dry Hole _____

Abandoned _____

Date

MAY 26 1954 19

J. G. McGEHEE

Scout

County Pawnee State Kansas
 Sec. 3 (Blk.) 23 (Sur.) 16W Map No.
 Operator G-M-R Oil
 Well No. 2 Farm Aldrich "A"
 Elev. 2050 Location NE NE SW

COMPLETE							

330 Ft. From N Line SW
330 Ft. From E Line Quarter
 Ist. Report
 Completion JUN 9 1954
 Remarks SW Shadey Pool
G-M-R - Contr.
 Spudding Date 4-12-54

Drlg. Data Oil well TD 4087
8" @ 428 Anhy 1005 Br. lime 3609
Lans. 3617 DST 3612-44 open 1 hr.
Rec. 60' vsocm 1170# DST 3647-62
open 2 hr. oil in 58 min. 1120#
DST 3746-70 open 1 hr. Rec. 134' mcw
1240# Cong. 3985 Simp. 4062
Arb. 4081 TD 4087 5" @ 4084
13/ 3707-11 S/ 3 $\frac{1}{2}$ boph 10% wtr.
SP 3680 23/ 3648-56 2000' A S. & F/
40 boph 9 hr. Comp. 2254 bopd

J. G. MCGEHEE