


Section 3 Township 23 Range 17WWell No. #2 HutchinsonCompany L.C. Knight & NCRA

NORTH

WEST

EAST

SOUTH

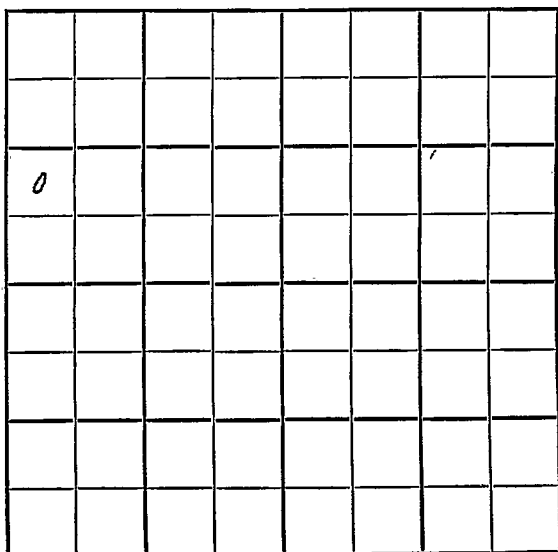

KANSAS

SEC.	TWP.	R.
3	23	17W

WELL NO.

#2 Hutchinson

FARM

COMPANY

L. C. Knight & NCRA

CONTRACTOR

Knight

Garfield Pool

NORTH

Ft. from N. Line


990

Ft. from S. Line

Ft. from E. Line

330

Ft. from W. Line

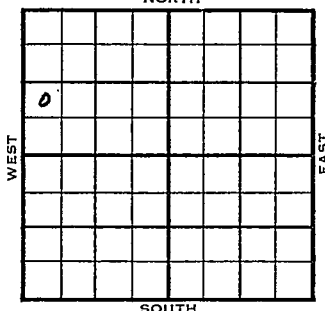

NW SW NE

1954

ELEVATION

2059:

REPORT

11/17

Location

12/22

Spud 11-16-54 Oil well TD 4255
8" @ 213 Anhy 1088 Heeb 3598
Tor. 3617 Doug 3631 Br lime 3704
Lans. 3711 Cherokee 4121
DST 4122-40 open 1 hr rec 4,500,000
CFG 1333# Reworked Miss 4141
DST 4149-74 open 1 hr rec 3000' free
oil 1285# Viola 4246 TD 4258
Schl tops: Cherokee 4119 Viola 4242
~~TD 4255~~ TD 4255 5" @ 4252 CO
10/4146-50 15/4162-68 2000 A
sd-oil-frac F/41 BOPH 2 hr.
F/24.44 BOPH 4 hr.
Comp. F/1032 BOPD

COMPLETED

County Pawnee State KansasSec. 3- (Blk.) 23 (Sur.) 17W Map No.Operator L. C. Knight & HCRAWell No. 2 Farm HutchinsonElev. Location NW SW NW

0							

990 Ft. From S Line NW330 Ft. From W Line Quarter1st. Report NOV 17 1954

Completion

Remarks


Knight - Contr.

Spudding Date

Drlg. Data Garfield PoolLocation

FABEN GILSTRAP

County Pawnee State Kansas
 Sec. 3 (Blk.) 23 (Sur.) 17W Map No.
 Operator L. C. Knight & NCRA
 Well No. 2 Farm Hutchinson
 Elev. 2059 Location NW SW NW

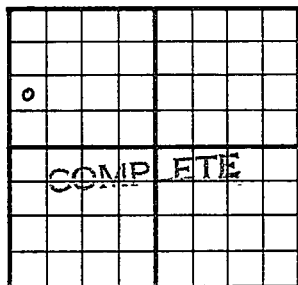

990 Ft. From S Line NW
330 Ft. From W Line Quarter

1st. Report

Completion DEC 22 1954

Remarks Garfield Pool

Knight - Contr.

Spudding Date 11-16-54

Drilg. Data Oil well TD 4255
8" @ 213 Anhy 1088 Heeb. 3598
Tor. 3617 Doug. 3631 Br. line 3704
Lans. 3711 Cherokee 4121 DST 4122-40
open 1 hr. Rec. 4,500,000 c/g 1333#
Reworked Miss. 4141 DST 4149-74 open
1 hr. Rec. 3000' free oil 1285#
Viola 4246 TD 4258 SCHLUMBERGER TOPS:
Cherokee 4119 Viola 4242 TD 4255
5" @ 4252 CO 10/ 4146-50 15/ 4162-68
2000 A sd-oil-frac F/ 41 boph 2 hr.
F/ 24.44 boph 4 hr. Comp. F/ 1032 bopd

FABEN GILSTRAP