


Section 3 Township 23 Range 17WWell No. 4 Hutchinson EstCompany Clark Knight & NCRA

NORTH

WEST

EAST

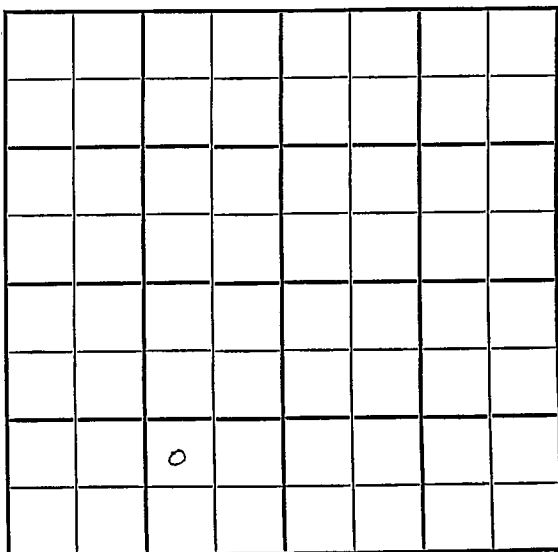

SOUTH

14

Pawnee

KANSAS

SEC.	TWP.	R.
3	23	17 W

WELL NO. # 4 Hutchinson Est. FARM

COMPANY Clark Knight & NCRA

CONTRACTOR Co. tools

Garfield Pool


_____ Ft. from N. Line

990 _____ Ft. from S. Line

990 _____ Ft. from E. Line

_____ Ft. from W. Line

NW SE SW

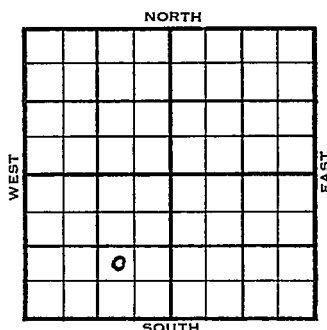

	ELEVATION	REPORT
--	-----------	--------

1955

4/27

Spud 4-23-55

10" @ 117

Drlg. 1004'

6/8

DST 4129-54, open 45 min. Rec. 55'
 mud, 150/20" DST 4158-4200, open 1 hr.
 Rec. 360' smco 1350/30" 5½ @ 4269-75
 42/4158-72 frac F/44 boph 4 hr. Comp.
 F/1550 bopd.

Tops:	Depth	Datum
Anh	1100	
H.	3610	1539
Tr.	3626	1555
Dg.	3639	1568
BL	3715	1644
L.	3721	1650
BKC	4003	1932
Ce.	4142	2071
C.	4158	2087
M.	4219	2148
TD.	4270	

COMPLETED

FABEN GILSTRAP

County Pawnee Elev. 2071
 Sec. 3 Twp. 23 Rge. 17W
 Company Clark Knight & NCRA
 FarmName Hutchinson Est. No. 4

TOPS	DEPTH	LOG	DATUM	Loc. in Sec.
Anh.	1100			NW SE SW
Tr.				
H.	3610		1539	
Tr.	3626		1555	
Dg.	3639		1568	
Bl.	3715		1644	
L.	3721		1650	
K.C.				Geol.
B.K.C.	4003		1932	Contr.
Ce.	4142		2071	
C.	4158		2087	
M.				
M.	4219		2148	Pool
K.				Garfield
Mz.				
Me.				
V.				
S.				
S.				
A				
R.				
Pe.				
G.				
T.D.	4270			

Date Comm. 4-3-55 JUN 8 1955

10" @ 117/90 DST 4129-54 open 45 min.

Rec. 55' mud 150/20" DST 4158-4200

open 1 hr. Rec. 360' smco 1305/30"

5 $\frac{1}{2}$ " @ 4269/75 42/ 4158-72 frac

F/ 44 boph 4 hr. Comp. F/ 1550 bopd