

Pawnee

KANSAS

SECTION 3 TOWNSHIP 23 RANGE 17 W


WELL NO. #6 Hutchinson Est.

COMPANY Clark Knight & NCRA

NORTH

WEST

EAST

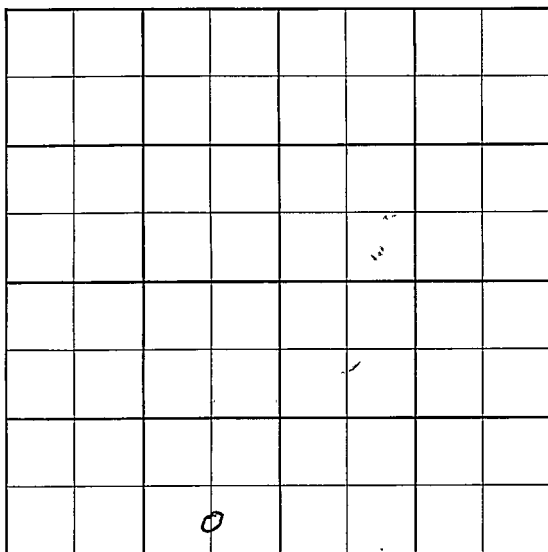

SOUTH

Pawnee

KANSAS

SEC.

TWP.

R.

3

23

17W

WELL NO.

#6 Hutchinson Est

FARM

COMPANY

Clark Knight & NCRA

CONTRACTOR

Knight


Garfield

Ft. from N. Line

Ft. from S. Line

Ft. from E. Line

Ft. from W. Line

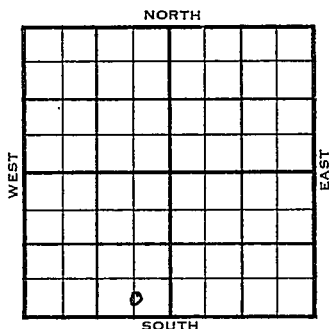C S $\frac{1}{2}$ SE SW

1955

ELEVATION

2093'

REPORT

10/26

Comm 10-19-55

8" @ 183/325'

Anh

1130

Drlg 2676

12-14

DST 4176-4226 op 1 hr. gas in 5 min.
rec. 210' socm, 1005/20"5 $\frac{1}{2}$ " @ 4284/100

CO 26/ 4183-93, 250 A, frac

F/ 30 boph 4 hrs

Comp. F/ 695 bopd

H. 3635

Tr. 3649

BL. 3740

L. 3748

BKC 4025

C. 4174

TD 4285

COMPLETED

 Sec. 3 Twp. 23 Rge. 17W
 Company Clark Knight & NCRA
 Farm Name Hutchinson Est. No. 6

TOPS	DEPTH	LOG	DATUM	Loc. in Sec.
Anb.	1130			C S $\frac{1}{2}$ SE SW
Tr.				
H.				
Tr.				
Dg.				
BL.				
L.				Geol.
K.C.				Contr.
B.K.C.				<u>Knight</u>
Ce.				Pool #
C.				<u>Garfield</u>
M.				
M.				
K.				
Mz.				
Me.				
V.				
S.				
S.				
A.				
R.				
Pe.				
G.				
T.D.				

FIRST REPORT
 OCT 26 '55

Date Comm. 10-19-55
 8011 @ 183/325 drlg. 2676

Co.

Lse.

No.

Sec.

T.

R.

County Pawnee Elev. 2093
 Sec. 3 Twp. 23 R. 17W
 Company Clark Knight & NCRA
 Farm Name Hutchinson Est. No. 6

TOPS/	DEPTH	LOG	DATUM	Loc. in Sec.
Anh.	<u>1130</u>			<u>G S$\frac{1}{2}$ SE SW</u>
Tr.	<u>3635</u>		<u>1542</u>	
Dg.	<u>3649</u>		<u>1556</u>	
Bl.	<u>3740</u>		<u>1647</u>	
L.	<u>3748</u>		<u>1655</u>	
K.C.				Geol.
B.K.C.	<u>4025</u>		<u>1932</u>	Contr.
Ce.				
C.	<u>4174</u>		<u>2081</u>	<u>Knight</u>
M.				
M.				Pool
K.				<u>Garfield</u>
Mz.				
Mo.				
V.				
S.				
S.				
A.				
R.				
P.C.				
G.				
T.D.	<u>4285</u>			

Date Comm. 10-19-55 DEC 14 1955
8" @ 183/325 DST 4176-4226 open 1 hr.
gas in 5 min. rec. 210' socm 1005/20"
5 $\frac{1}{2}$ " @ 4284/100 CO 26/ 4183-93
250 A frac F/ 30 boph 4 hr.
Comp. F/ 695 bopd