

Section 3 Township 23 Range 17W

Well No. #2 Hutchinson Est "F"

Company Honaker & NGRA

NORTH

12

WEST

EAST

0

SOUTH

Pawnee KANSAS

SEC.	TWP.	R.
3	23	17W

WELL NO. 2 Hutchinson Est. "F" FARM

COMPANY Honaker & NCRA

CONTRACTOR Honaker


NE Garfield Pool

330 Ft. from N. Line

Ft. from S. Line

Ft. from E. Line

330 Ft. from W. Line

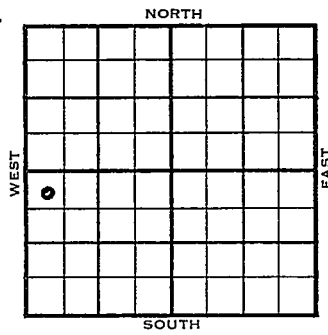

NW NW SW

	ELEVATION	REPORT
1955	2067'	

1/5 MIR

2/9 Spud 1-4-55 - Oil Well
 TD 4276'
 8" @ 246'
 Anhy 1100', Ft. Riley 1750', Br. lime 3715', Lans. 3724', Cong. 4132', Ch. Cong. 4153'
 DST 4154-63', opn 25", gas in 3"
 F/oil in 25", 1200#
 DST 4175-95', opn 1 hr., rec. 30' mud, 280 #
 Viola 4260'
 TD 4276'
 5" @ 4275', CO
 56/4178-90
 Sd-oil-frac
 F/45 bo 1 hr.
 C omp. 484 bopd

COMPLETED

County Pawnee State Kansas

Sec. 3 (Blk.) 23 (Sur.) 17W Map No. (Twp.) (Rge.)

Operator Honaker Drlg. & NCRA

Well No. 2 Farm Hutchinson Est. "F"

Elev. 2067 Location NW NW SW

0					

330 Ft. From N Line SW

330 Ft. From W Line Quarter

Ist. Report

Completion FEB 9 1955

Remarks NE Garfield Pool

Honaker - Contr.

Spudding Date 1-4-55

Drlg. Data Oil well TD 4276

8" @ 246 Anhy 1100 Ft. Riley 1750

Br. lime 3715 Lans. 3724 Cong. 4132

Ch. Cong. 4153 DST 4154-63 open 25 min.

gas in 3 min. F/ oil in 25 min. 1200#

DST 4175-95 open 1 hr. Rec. 30' mud

280# Viola 4260 TD 4276 5" @ 4275

CO 56/ 4178-90 sd-oil-frac

F/ 45 bo 1 hr. Comp. 484 bopd

FABEN GILSTRAP