


Section 3 Township 23 Range 17 W

Well No. #6 Hutchinson "F"

Company Colorado O & G & NORA

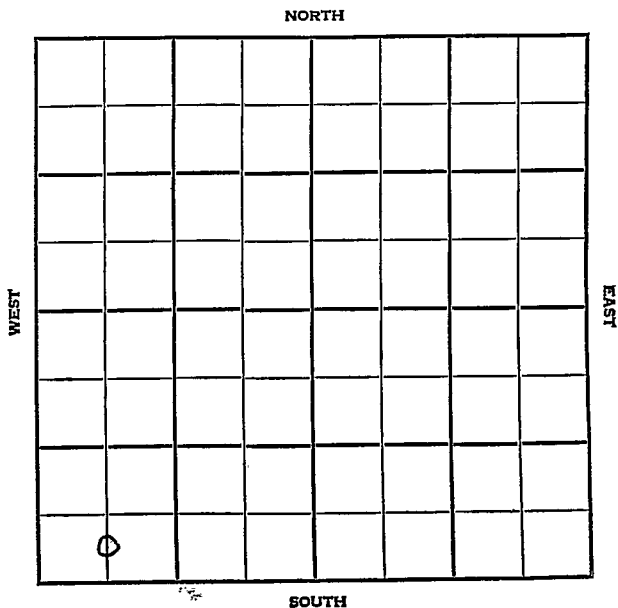

13

WEST

EAST

Pawnee

KANSAS

SEC.	TWP.	R.
3	23	17W

WELL NO.

#6 Hutchinson "F"

FARM

COMPANY

Colorado O&G & NCRA

CONTRACTOR

Honaker


Garfield

_____ Ft. from N. Line

_____ Ft. from S. Line

_____ Ft. from E. Line

_____ Ft. from W. Line

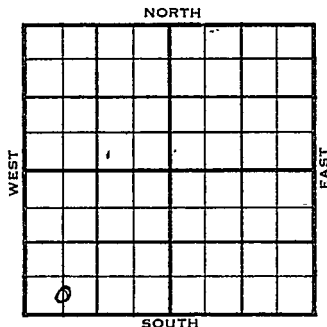C S $\frac{1}{2}$ SW SW

1956

ELEVATION

2091'

REPORT

3-7

Comm. 3-1-56
 8" @ 243/175
 Drlg. 2550

5-23

DST 4235-54 op 1 $\frac{1}{2}$ hr. rec. 116' socm,
 150/20"
 5 $\frac{1}{2}$ " @ 4314/200
 CO to 4281, 24/ 4234-40
 B/ 2 boph, 500 A,
 S/ 4 go, 6 hrs.,
 PB 4228, 24/ 4198-4204, 500 A, frac
 F/ 3 boph, 4 hrs.,
 Comp. 101 bopd.
 H. 3637', L. 3756', C. Shly 4164',
 Cg. chert 4191', V. 4287'
 TD 4315'

COMPLETED

County Pawnee Elev. _____
 Sec. 3 Twp. 23 Rge. 17W
 Company Colorado O & G & NCRA
 Farm Name Hutchinson #1111 No. 6

TOPS	DEPTH	LOG	DATUM
Anh.			
Tp.			
H.			
Tr.			
Dg.			
Bl.			
L.			
K.C.			
B.K.C.			
Ce.			
C.			
M.			
M.			
K.			
Mz.			
Me.			
V.			
S.			
S.			
A.			
R.			
PE.			
G.			
T.B.			

Loc. in Sec. G S $\frac{1}{2}$ SW SW

Geol. _____
 Concr. _____
 Bonaker
 Pool Garfield

MAR 7 1956
 FIRST REPORT
 0

Date Comm. 3-1-56
8" @ 243/175 drlg. 2550



Co.
Lse.
No.
Sec.
T.
R.

County Pawnee Elev. 2091
 Sec. 3 Twp. 23 Rge. 17W
 Company Colorado O & G & NCRA
 Farm Name Hutchinson "F" No. 6

TOPS	DEPTH	LOG	DATUM	Loc. in Sec.
Anh.				C S $\frac{1}{2}$ SW SW
Ip.				
H.	<u>36.97</u>			
Tr.				
Dg.				
Bl.				
L.	<u>3756</u>		<u>1665</u>	Geol.
K.C.				Contr.
B.K.C.				
Ce.				Honaker
C. <u>shaly</u>	<u>4164</u>		<u>2073</u>	
M. <u>Cg chert</u>	<u>4191</u>		<u>2100</u>	Pool
M.				Garfield
K.				
Mz.				
Mq.				
V.	<u>4287</u>		<u>2196</u>	COMPLETE
S.				
S.				
A.				
R.				
PE.				
G.				
T.D.	<u>4315</u>			

Date Comm. 3-1-56 MAY 23 1956
8" @ 243/175 DST 4235-54 open 1 $\frac{1}{2}$ hr.
rec. 116' socm 150/20" 5 $\frac{1}{2}$ " @ 4314/200
GO to 4281 24/ 4234-40 B/ 2 gmph
500 A S/ 4 go 6 hr. PB 4228
24/ 4198-4204 500 A frac
F/ 3 boph 1 hr. Comp. 101 bopd