


Section 3 Township 23 Range 17W

Well No. #2 Hutchinson "H"

Company Honaker & Colorado Oil & Gas

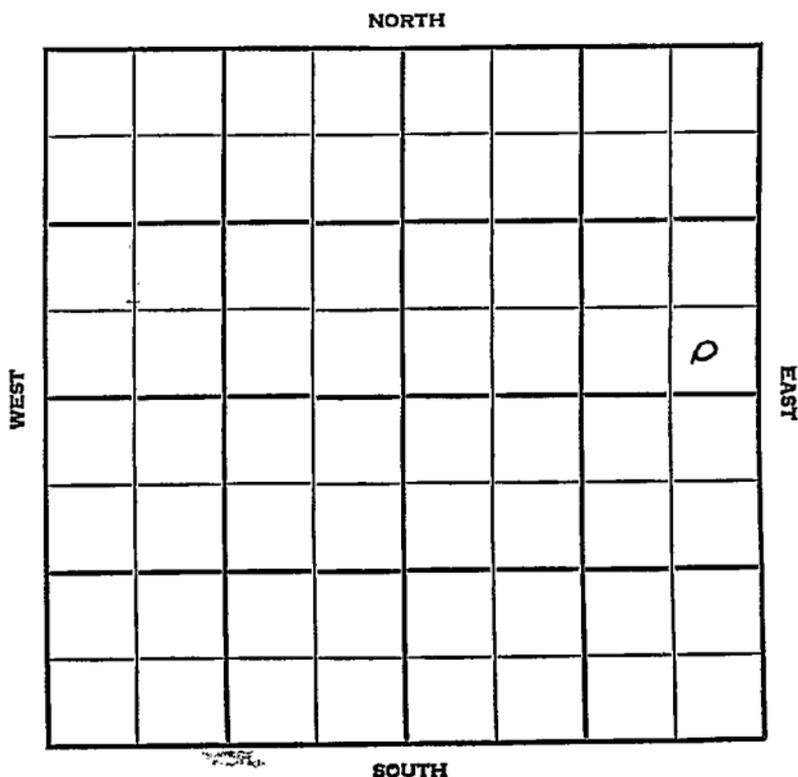


SEC.	TWP.	R.
3	23	17 W

WELL NO. # 2 Hutchinson "H" FARM

COMPANY Honaker & Colorado Oil & Gas

CONTRACTOR Honaker Drlg.
Garfield Pool

_____ Ft. from N. Line
330 _____ Ft. from S. Line
330 _____ Ft. from E. Line
_____ Ft. from W. Line

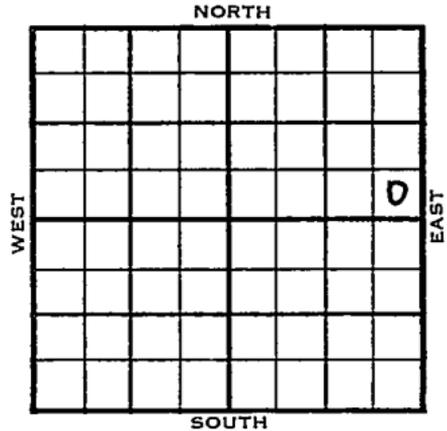

SE SE NE

1955	ELEVATION	REPORT
	2091'	
1/12		Spud 1-11-54 8" @ 240
3/9		Spud 1-11-54 - Oil Well TD 4292' 8" @ 240' Anhy 1105', Heeb 3630', Doug. 3660', Br Lime 3737', Lans. 3745', Cong. 4151', h. Cong. 4171' DST 4172-93', opn 1 hr., gas to surface in 2", spray oil in 28", 1,000,000cfg 120' HO&GCM, 1330# DST 4186-4201', opn 1 hr., rec. 95' ho & gcm, 1380# DST 4205-24', opn 35", rec. 15' mud, 195# TD 4292' 5" @ 4291' 26/4206-14, frac F/4,000,000 cfg, Viola 4270' omp. 137 bopd

COMPLETED

County Pawnee State Kansas
 Sec. 3 (Blk. 23) (Sur. 17W) Map No. 17W
 Operator Honaker & Colorado Oil & Gas
 Well No. 2 Farm Hutchinson "H"
 Elev. 2091 Location SE SE NE

330 Ft. From S Line NE
330 Ft. From E Line Quarter
 1st. Report _____
 Completion MAR 9 1955
 Remarks Garfield - Pool
Honaker Drlg. - Contr.
 Spudding Date 1-11-54

Drlg. Data Oil well TD 4292
8" @ 240 Anhy 1105 Heeb. 3630
Doug. 3660 Br. lime 3737 Lans. 3745
Cong. 4151 Ch. Cong. 4171 DST 4172-93
open 1 hr. gas to surface in 2 min.
spray oil in 28 min. 1,000,000 cfg
120' ho & gcm 1330# DST 4186-4201
open 1 hr. Rec. 95' ho & gcm 1380#
DST 4205-24 open 35 min. Rec. 15' mud
195# TD 4292 5" @ 4291 26/ 4206-14
frac F/ 4,000,000 cfg Viola 4270
Comp. 137 bopd

FABEN GILSTRAP