


Section 3 Township 23 Range 17W

Well No. #3 Hutchinson "H"

Company Honaker Drlg. & Colorado O & G

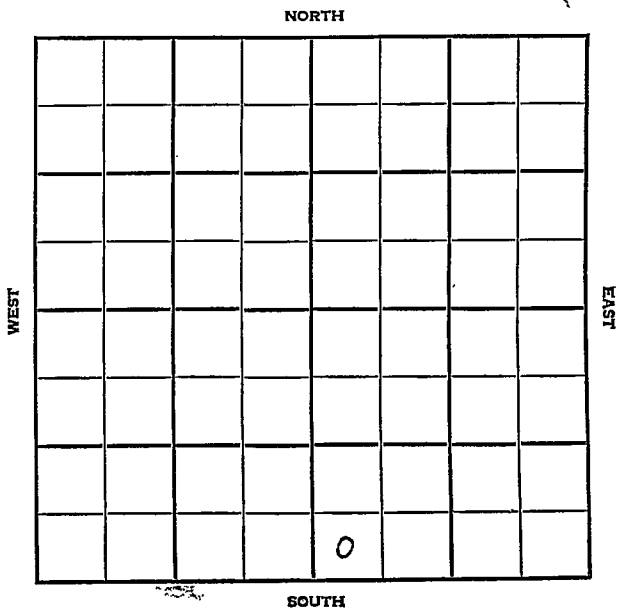

Pawnee

KANSAS

SEC.	TWP.	R.
3	23	17 W

WELL NO.

3 Hutchinson "H"

FARM

COMPANY

Honaker Drlg. & Colorado Oil & Gas

CONTRACTOR

Co. tools

Garfield Pool


_____ Ft. from N. Line

330 _____ Ft. from S. Line

_____ Ft. from E. Line

330 _____ Ft. from W. Line

SW SW SE

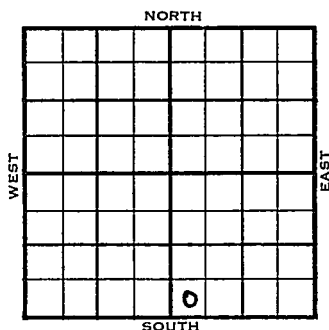

1955

ELEVATION

2098'

REPORT

1/12

Location

4/27

Spud 2-8-55 - Oil Well

TD 4304'

8" @ 250'

Cong. 4148', Cong. chert 4187'

DST 4210-29', failed

DST 4188-4229', rec. 15' mud, 135#

DST 4232-41', opn 1½ hrs., rec. 55'

so&gcm, 185#

Viola 4296'

DST 4267-4304', opn 20", rec. 8' mud, 1200#

TD 4304'

5" @ 4303'

30/4200-08, frac, 500A

/2½ bfph 2 hrs.

Re-frac, CO 4271

17/4234-38, 1 qt. oil ph frac 500A

1 boph frac 500A 3 bwph 3 hrs.

29/4222-26, 7 go 3 hrs., frac.

Heeb. 3638', Br lime 3745', 1 ans.

3753'

S/1.68 bf 62% wtr.

Comp. 25 bopd 30% wtr.

COMPLETED

