


Section 3 Township 23 Range 17 W

Well No. #5 Hutchinson "H"

Company Honaker Drlg. & Colorado O & G

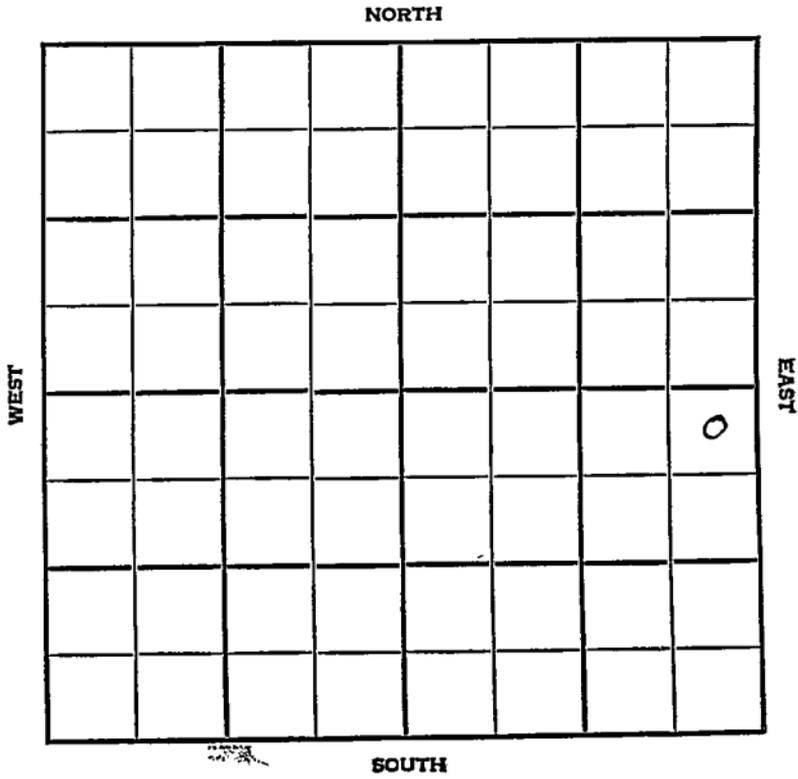

SEC. 3	TWP. 23	R. 17W
-----------	------------	-----------

WELL NO. #5 Hutchinson "H" FARM

COMPANY Honaker Drlg. & Colorado (O &G)

CONTRACTOR Co. tools

Jab


\_\_\_\_\_ Ft. from N. Line

\_\_\_\_\_ Ft. from S. Line

\_\_\_\_\_ Ft. from E. Line

\_\_\_\_\_ Ft. from W. Line

NE NE SE

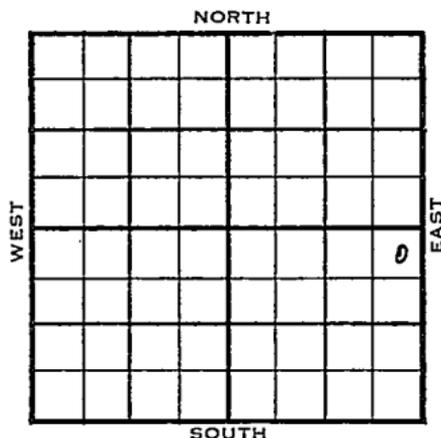

1955	ELEVATION 2091'	REPORT
------	--------------------	--------

9-14 Location

10/19 Comm 9-14-55  
 8 5/8" @ 222/175  
 5 1/2" @ 4317 w/175  
 H 3638  
 BL 3747  
 L 3755  
 shly 4167  
 Cong Ch 4184  
 V 4312  
 TD 4318  
 CO to 4306 40/4220-30 500 A  
 30 bo frac F/54 boph  
 Comp BHB F/3000 bopd

**COMPLETED**



County Pawnee Elev. 2091  
 Sec. 3 Twp. 23 Rge. 17W  
 Company Honaker Drlg. & Colorado O & G  
 Farm Name Hutchinson "H" No. 5

TOPS	DEPTH	LOG	DATUM	Loc. in Sec.
Anh.				NE NE SE
Tp.				
H.	.3638		1547	
Tr.				
Dg.				
Bl.	.3747		1656	
L.	.3755		1664	
K.C.				Geol.
B.K.C.				Contr.
Ce.				Co. tools
C. <i>shale</i>	4167		2076	
M. <i>Comp. (sh.)</i>	4184		2093	
M.				Pool
K.				<i>John Garfield</i>
Mz.				
Me.				
V.	4312		2221	
S.				
S.				
A				
R.				
PE.				
G.				
TR.	4318			

Date Comm. 9-14-55 OCT 19 1955

8 5/8" @ 242/175 5 1/2" @ 4317/175

CO to 1306 40/ 4220-30 500 A

30 bo frac F/ 54 bopd

Comp. BHB F/ 3000 bopd

COMPLETE