


Pawnee **KANSAS**
23 RANGE 17 W

SECTION 3 TOWNSHIP _____

WELL NO. #7 Hutchinson "H"

COMPANY Colorado O & G

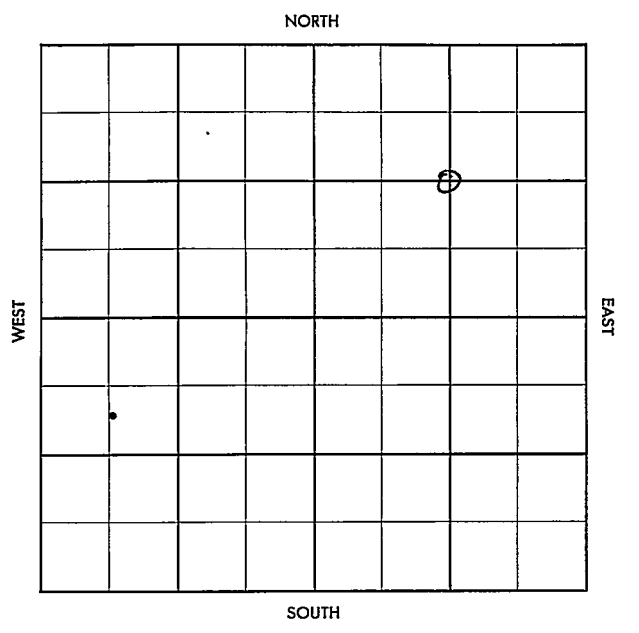

Pawnee

KANSAS

SEC. 3	TWP. - - 23	R. 17W
-----------	----------------	-----------

WELL NO. #7 Hutchinson "H" FARM

COMPANY

Colorado O&G

CONTRACTOR
Honaker

Garfield


_____ Ft. from N. Line

_____ Ft. from S. Line

_____ Ft. from E. Line

_____ Ft. from W. Line

~~###~~ C NE/4

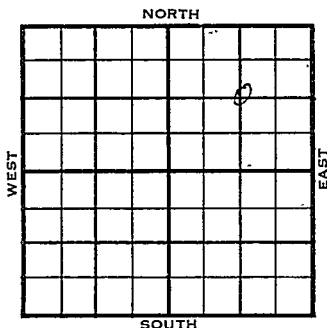

19566	ELEVATION	REPORT
-------	-----------	--------

1-5	Comm. 1-2-56 8" @ 238/175 Drl g. # 247
-----	--

County Paynee Elev. _____
 Sec. 3 Twp. 23 Rge. 17W
 Company Colorado O & G
 Farm Name Hutchinson "H" No. 7

TOPS	DEPTH	EOG	DATUM
Anb.			
Tp.			
H.			
Tr.			
Dg.			
Bl.			
L.			
K.C.			
B.K.C.			
Ce.			
C.			
M.			
M.			
K.			
Mz.			
Ma.			
V.			
S.			
S.			
A.			
R.			
Pe.			
G.			
T.D.			

Loc. in Sec. C NE/4
 Geol. _____
 Contr. Honaker
 Pool Garfield
 JAN 5 '56
 FIRST REPORT

Date Comm. 1-2-56
8" @ 238/175 drlg. 247

~~H~~

Co.
Lse.
No.
Sec.
T.
R.

County Paria Elev. 2059
 Sec. 3 Twp. 23 Rge. 17W
 Company Colorado O & G
 Farm Name Hutchinson "H" No. 7

TOPS	DEPTH	LOG	DATUM	Loc. in Sec.
Anh				<u>G NE/4</u>
Tp.				
H.				
Tr.				
Dg.				
Bl.				
L.	<u>3714</u>		<u>1655</u>	Geol.
KC				Contr.
BKC				
Ce.	<u>sh</u>	<u>4121</u>	<u>2062</u>	<u>Honaker</u>
C.M.	<u>cg chert</u>	<u>4127</u>	<u>2068</u>	
N.				<u>Garfield</u>
K.				
Ms.				
Ms.				
V.				
S.				
S.				
A.				
R.				
PE				
G.				
TD	<u>4265</u>			COMPLETE

Date Comm. 1-2-56 FEB 29 1956
8" @ 238/175 d rlg. 247 JAN 11 '56 @ 3744
JAN 18 '56 5 1/2 4264/1175 JAN 25 '56 C O
40/4/65 = 75 s.o. 1/2 \$1.26 Boph
FRAC AV 2.93 Boph 11 hrs
POP FEB 1 '56 ✓ FEB 8 '56 ✓ FEB 15 '56 ✓ FEB 22 '56
use POP FEB 29 '56 PH P 40 Boph
+ 12% w/h