KANSAS


Pawnee

DX 78-1

Section 3 Township 23 Range 18 W

Well No. #1 Powers

Company ~~W. E. Leigan, Sr. et al~~

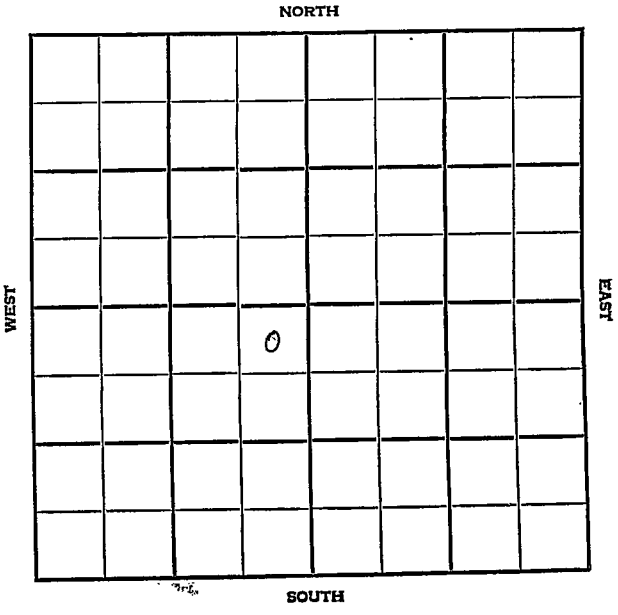

Pawnee KANSAS

SEC.	TWP.	R.
3	23S	18W

WELL NO.

#1 Powers FARM

COMPANY

W. E. Leigan, Sr. et al

CONTRACTOR

A. L. Jackson

Garfield


_____ Ft. from N. Line

_____ Ft. from S. Line

_____ Ft. from E. Line

_____ Ft. from W. Line

NE NE SW
DS-SW/4

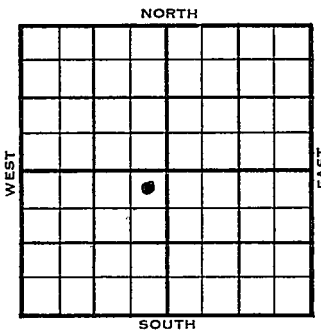

1955	ELEVATION 2113	REPORT
7/20	MIRT	
8/10	Comm 7/19/55 H 3723 B1 3828 L 3829 C 4311 M 4357 K 4410 V 4453 8 5/8" @ 222 w/175 DST 4285-4342 30" rec 30' M BHP 950/30" D & A	

ABANDONED

DX-78

FORM 513 REV. SUNRAY

County Pawnee Elev.

Sec. 3 Twp. 23S Rge. 18W

Company W. E. Leigan, Sr, et al

Farm Name Powers No. 1

TOPS	DEPTH	LOG	DATUM
Anh.			
T.P.			
H.			
Tr.			
Dg.			
B.L.			
L.			
K.C.			
B.K.C.			
Ce.			
C.			
M.			
M.			
K.			
Mz.			
Mq.			
V.			
S.			
S.			
A			
R.			
P€.			
G.			
T.D.			

Loc. in Sec. NE NE SW

DS-SW/4

Geol.

Contr. A.L.Jackson

Pool Garfield, W.

FIRST REPORT

D

JUL 20 '5[illegible]

Date Comm. MIRT

Co. Lse. No. Sec. T. R.

FORM 513 REV. SUNRAY

County Pawnee Elev. 2113

Sec. 3 Twp. 23S Rge. 18W

Company W. E. Leigan, Sr. et al

Farm Name Powers No. 1

TOPS	DEPTH	LOG	DATUM
Anh.			
Tp.			
H.	3723		1610
Tr.			
Dg.			
Bl.	3828		1715
L.	3829		1726
K.C.			
B.K.C.			
Ce.			
C.	4311		2198
M.	4357		2244
M.			
K.	4410		2297
Mz.			
Mo.			
V.	4453		2340
S.			
S.			
A			
R.			
P€.			
G.			
T.D.	4475		

Loc. in Sec. NE NE SW

DS-SW/4

Geol. Hoover

Contr. A. L. Jackson

Pool Garfield, W.

ABANDONED

AUG 10 1955

Date Comm. 7/19/55 85/8" 222 w/175

DST 4285-4342 30" rec. 30' M BHP 950/30"

D & A

Co. Lse. No. Sec. T. R.