


Finney

KANSAS

SECTION 3 TOWNSHIP 23 RANGE 32W

WELL NO. #1 Ben Gerber

COMPANY The Texas Co., etal

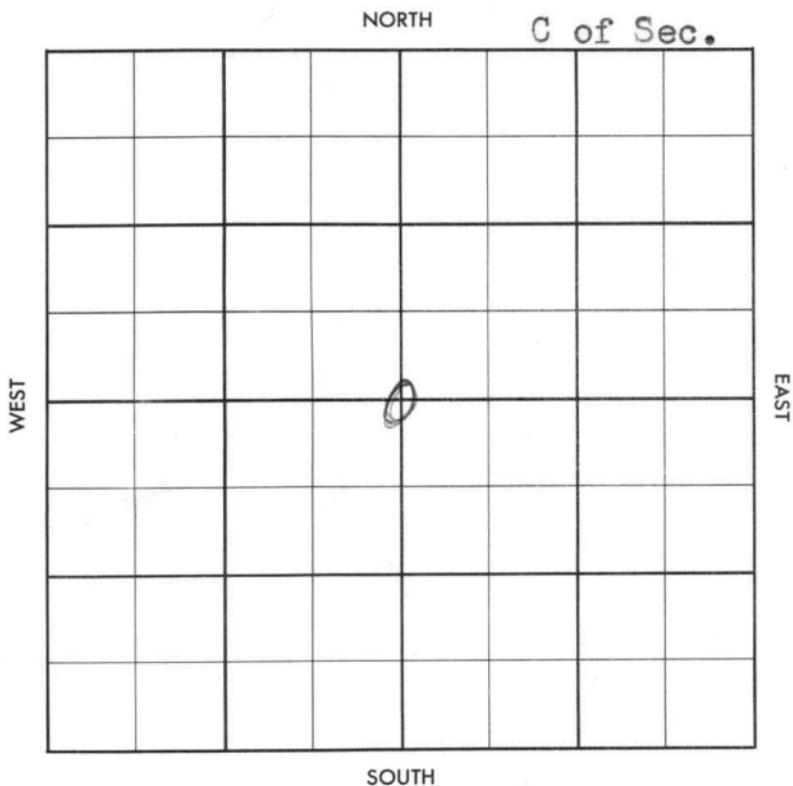

County Finney Elev. \_\_\_\_\_  
 Sec. 3 Twp. 23 Rge. 32W  
 Company The Texas Co. etal  
 FarmName Ben Berber No. 1

TOPS	DEPTH	LOG	DATUM
Anh.			
TP.			
H.			
Tr.			
Dg.			
Bl.			
L.			
K.C.			
B.K.C.			
Ce.			
C.			
M.			
M.			
K.			
Mz.			
Me.			
V.			
S.			
S.			
A.			
R.			
PE.			
G.			
T.D.			

Loc. in Sec. C OF SEC.  
 Geol. \_\_\_\_\_  
 Contr. \_\_\_\_\_  
Noble Drlg.  
 Pool Hugoton Gas Area  
 FIRST REPORT  
 APR 10 '57

Date Comm. 4-7-57  
8" @ 525/350, Drlg. 600

~~35~~

Co.  
Lse.  
No.  
Sec.  
T.  
R.

CORRECTION

FORM 513 SUNRAY

Co.

Loc.

No.

Sec.

T.

R.

County Finney Elev. 2925 KB  
 Sec. 3 Twp. 23 Rge. 32W  
 Company The Texas Co. etal  
 Farm Name Ben Gerber No. 1

TOPS	DEPTH	LOG	DATUM	Loc. in Sec.
Anh. <u>Hall</u>		<u>2643</u>		C OF SEC.
Tp. <u>HEAR</u>		<u>2673</u>		
H. <u>KPI</u>		<u>2695</u>		
Tr.				
Dg.				
Bl.				
L.				Geol. _____
K.C.				Contr. _____
B.K.C.				
Ce.				<u>Noble Drlg.</u>
C.				
M.				Pool _____
M.				<u>Hugoton Gas</u>
K.				<u>Area</u>
Mz.				
Mo.				
V.				
S.				
S.				
A.				
R.				
Pe.				
G.				
T.D.	<u>2697</u>			

Date Comm. 4-7-57

8" @ 525/350, Drlg. 600 APR 17 57 5 1/2 2687  
 1700 CO DD 2700 tstd ~~21~~ 21  
 MCFG APR 24 57 DD 2707 tstd 23  
 MCFG Frac tstd 2,540 MCFG  
 + 7 1/2 Gwph Plg @ 2684 36/  
 2674-83 24/2644-50 tstd  
 2,680 MCFG Frac CO 2705 tstd  
 1,518 MCFG tstd 2,334 MCFG  
 + 18 Gwph MAY 1 57 72-20 ga. 7,187  
 MCFGPD