


Section 3 Township 23 Range 33W

Well No. #1 J. J. Meyer

Company Northern Pump

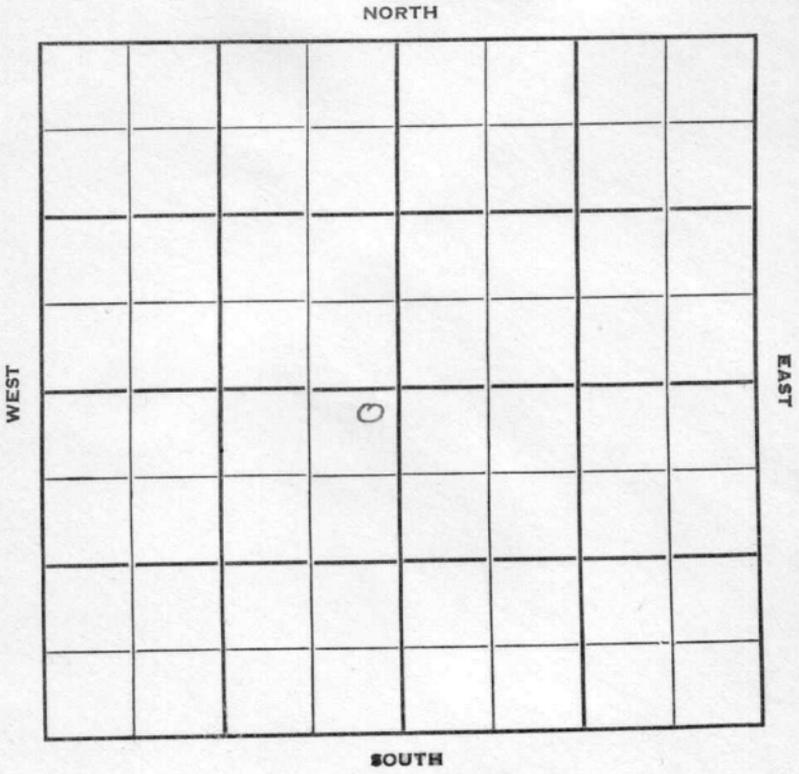

Sec. 3 Twp. 23 R. 33 W

Well No. # 1 J. J. Meyer Farm

Northern Pump Company

Contractor


150 Ft. from N. Line

Ft. from S. Line

150 Ft. from E. Line

Ft. from W. Line

NE SW

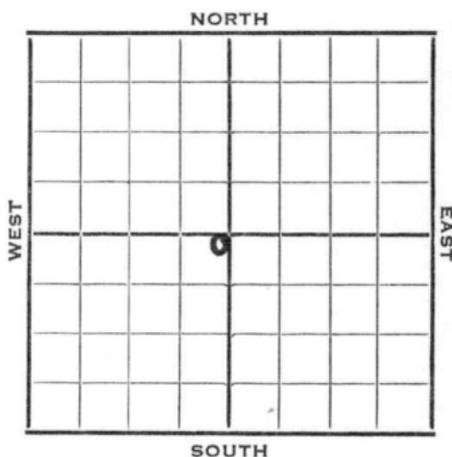

1952	Elev. 2874' REPORT
11/5	MIR
11/12	Her 2512' Krider 2531' Winfield 2570' Log
11/20	5" @ 2573'
11/27	NR
12/4	DD 2593'
12/11	27,500A
12/17	Spud 11-5-52
	Gas Well
	TD 2593
	Her 2512, Kri 2531, Win 2570,
	5" @ 2573
	DD 2593 27000A
	Comp. 5,665,000 gas
	<b>COMPLETED</b>



