

KANSAS


FORM 51 5M 6-46 PETROL

Kearny county

Section 3 Township 23 Range 35-W


Well No. #1, Miller "H"

Company Cities Service Oil Company

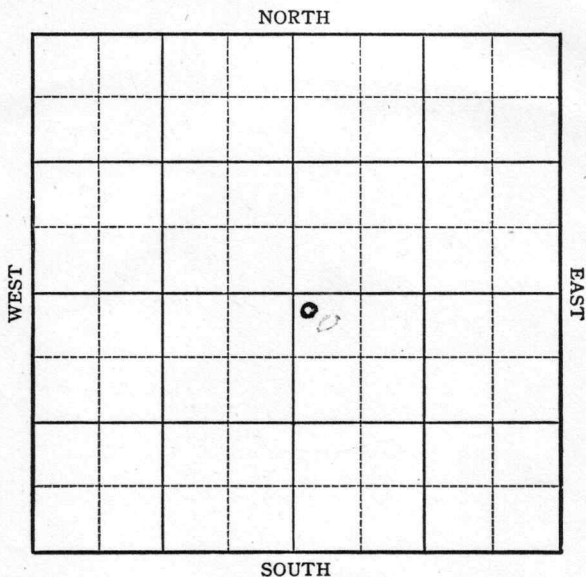

Sec. 3 Twp. 23 R. 35-WWell No. #1 Miller "H" FarmCities Service Oil Company Company
Hugoton100' Ft. from N. Line Ft. from S. Line Ft. from E. Line100' Ft. from W. Line

NW SE

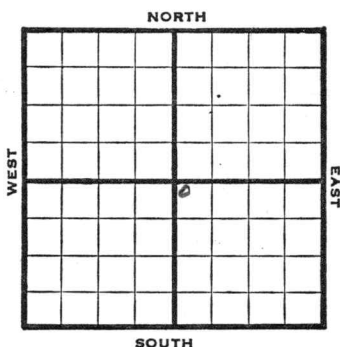

1946

Elev. 3028

REPORT

10/2	Location
10/8	"
10/15	"
10/22	"
10/29	"
11/6	"
11/12	"
11/20	Drlg 490'
11/27	8" @ 799' Drlg 1800'
12/3	TD 2660' Run 5"
12/10	5" @ 2652, RUST
12/17	155 shots 2535-58 85 shots 2593-2610'
1947	
1/4	35000 acid
1/8	" "
1/15	5" @ 2652' TD 2660' Perf 35000 Acid 14,500,000 Gas 386# R PR

COMPLETED.

Kansas Pool Name Hugoton

KANSAS

Map No. _____ Sec. 3 Twp. 23 R. 35WWell No. 1 Miller "H"

Cities Service

Company

FIRST REPORT

Contractor

NW SE

SECTION PLAT

		0	

100 Ft. from N. Line

_____ Ft. from S. Line

_____ Ft. from E. Line

100 Ft. from W. Line

Kearny County

Location X

Rig up _____

Drilling and Remarks:

RECORD

Cased _____ in., _____ ft.

Sand _____

Gas _____

Oil _____

Total Depth _____

PRODUCTION

1st 24 hrs. Nat. _____

1st 24 hrs. after shot _____

Gas _____ Cu. Ft.

Dry Hole _____

Abandoned _____

Date

OCT 2 1946 19 S. J. LEWIS Scout

Kansas **KANSAS**Map No. _____ Sec. 3 Twp. 23 R. 35WWell No. 1 Miller "H"

Cities Service

Company

COMPLETE

Contractor

NW SE

E. J. 3028

SECTION PLAT

		o	

100 Ft. from N. Line

_____ Ft. from S. Line

_____ Ft. from E. Line

100 Ft. from W. Line

Kearny County

Location _____

Rig up _____

Drilling and Remarks:

*5' 02652**Prof.**35000 acut**14,500,000 Gas**386* R P*

RECORD

Cased _____ in., _____ ft.

Sand _____

Gas _____

Oil _____

Total Depth 2660

PRODUCTION

1st 24 hrs. Nat. _____

1st 24 hrs. after shot _____

Gas _____ Cu. Ft.

Dry Hole _____

Abandoned _____

Date

JAN 15 1947

19

S. J. LEWIS

Scout