

Kearny


DX 78-1

KANSAS

Section 3 Township 23 Range 37W

Well No. #1 Powers Gas Unit

Company Stanolind

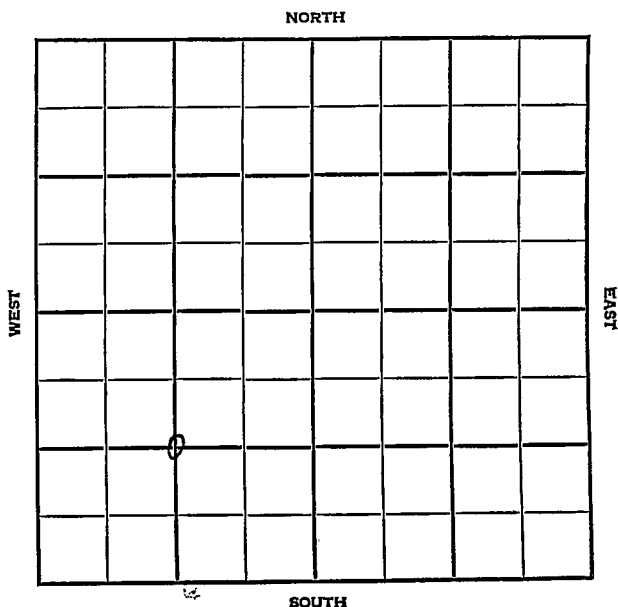

Kearny

KANSAS

SEC.	TWP.	R.
3	23	37W

WELL NO.

#1 Powers Gas Unit

FARM

COMPANY

Stanolind

CONTRACTOR

Barbour

Hugoton Pool

Ft. from N. Line


1320

Ft. from S. Line

Ft. from E. Line

1320

Ft. from W. Line

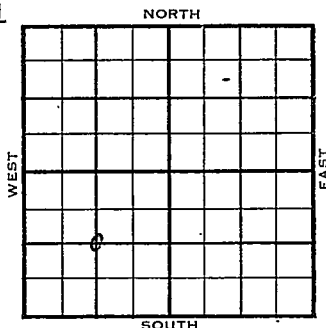

C SW/4

	ELEVATION	REPORT
1954	3269'	

11/11

Spud 11-5-54

8" @ 825'

WOC.

12/8

Spud 11-5-54 - Was Well

TD 2731'

8" @ 825'

Her. 2548', Win. 2600', Kri 2561',

Tow. 2659', Ft. Riley 2695'

TD 2731'

5" @ 2695'

CO to 2731', 3000A

1,476,000 cfg, 200 gwph, 823,000 cfg

83 gwph

PB 2710

901,000 cfg 30 gwph

PB 2704' 36/2672-78, 54/2659-68,

42/2642-49, 18/2627-30, 30/2616-21,

78/2600-13, 24/2574-78, 24/2565-69,

66/2550-61, 520,000 cfg, 33 gwph

Dolo-frac, 3000 gals, 2,239,000 cfg.

25 gwph

Comp. 7,108,000 cfcpd, 338#

COMPLETED

County Kearny State Kansas
 Sec. 3 (Blk. Twp.) 23 (Sur. Rge.) 37W Map No.
 Operator Stanolind
 Well No. 1 Farm Powers Gas Unit
 Elev. Location C SW/4

1320 Ft. From S Line SW
1320 Ft. From W Line Quarter
 Ist. Report NOV 10 1954
 Completion
 Remarks
Barbour - Contr.
 Spudding Date 11-15-54

Drlg. Data Hugoton Pool
8" @ 825 WOC

FABEN GILSTRAP

County	Kearny		State	Kansas	
Sec.	3	(Blk. Twp.) 23	(Sur. Rge.) 37W	Map No.	
Operator	Stanolind				
Well No.	1	Farm	Powers Gas Unit		
Elev.	3269	Location	C SW/4		

1320 Ft. From	S Line	SW
1320 Ft. From	W Line	Quarter
1st. Report		
Completion	DEC 8 1954	
Remarks	Hugoton Pool	
Barbour - Contr.		
Spudding Date	11-5-54	

Drilg. Data	Gas well	TD 2731
8" @ 825	Her. 2548	Win. 2600
		Kri. 2561
Tow. 2659	Ft. Riley 2695	TD 2731
5" @ 2695	CO to 2731	3000 A
1,476,000 cfg	200 gwph	823,000 cfg
83 gwph	22PB 2710	901,000 cfg
	30 gwph	
PB 2704	36/ 2672-78	54/ 2659-68
42/ 2642-49	18/ 2627-30	30/ 2616-21
78/ 2600-13	24/ 2574-78	24/ 2565-69
66/ 2550-61	520,000 cfg	33 gwph
dolo-frac	3000 gal.	2,239,000 cfg
25 gwph	Comp. 7,108,000 cfgpd	338#

FABEN GILSTRAP