

STATE CORPORATION COMMISSION OF KANSAS
OIL & GAS CONSERVATION DIVISION
WELL COMPLETION FORM
ACO-1 WELL HISTORY
DESCRIPTION OF WELL AND LEASE

Operator: License # 5886

Name: Chief Drilling, Inc.

Address 224 E. Douglas, #530

City/State/Zip Wichita, Kansas 67202

Purchaser: none

Operator Contact Person: Douglas W. Thimesch

Phone (316) 262-3791

Contractor: Name: Chief Drilling, Inc.

License: 5886

Wellsite Geologist: Wesley D. Hansen

Designate Type of Completion

☒ New Well ☐ Re-Entry ☐ Workover

☐ Oil ☐ SWD ☐ Temp. Abd.

☐ Gas ☐ Inj ☐ Delayed Comp.

☒ Dry ☐ Other (Core, Water Supply, etc.)

If OWO: old well info as follows:

Operator: _____

Well Name: _____

Comp. Date _____ Old Total Depth _____

Drilling Method:

☒ Mud Rotary ☐ Air Rotary ☐ Cable

3-2-91 3-11-91 3-11-91

Spud Date Date Reached TD Completion Date

API NO. 15- 055-20,952

County Finney

NE SE NW Sec. 8 Twp. 23S Rge. 30W East West

3630 Ft. North from Southeast Corner of Section

2970 Ft. West from Southeast Corner of Section
(NOTE: Locate well in section plat below.)


Lease Name Haag Well # 3-8

Field Name ---

Producing Formation none

Elevation: Ground 2848 KB 2855

Total Depth 4980' PBTD ---

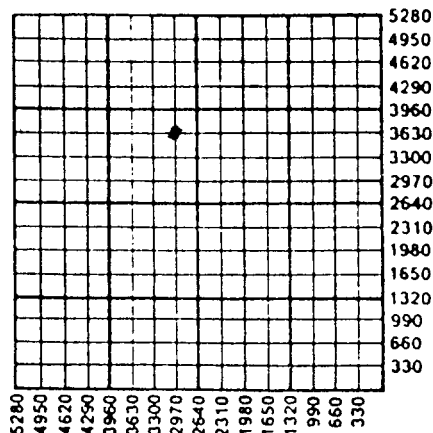

Amount of Surface Pipe Set and Cemented at 309' Feet

Multiple Stage Cementing Collar Used? ☐ Yes ☒ No

If yes, show depth set --- Feet

If Alternate II completion, cement circulated from ---

feet depth to --- w/ --- sx cmt.

INSTRUCTIONS: This form shall be completed in triplicate and filed with the Kansas Corporation Commission, 200 Colorado Derby Building, Wichita, Kansas 67202, within 120 days of the spud date of any well. Rule 82-3-130, 82-3-107 and 82-3-106 apply. Information on side two of this form will be held confidential for a period of 12 months if requested in writing and submitted with the form. See rule 82-3-107 for confidentiality in excess of 12 months. One copy of all wireline logs and drillers time log shall be attached with this form. ALL CEMENTING TICKETS MUST BE ATTACHED. Submit CP-4 form with all plugged wells. Submit CP-111 form with all temporarily abandoned wells. Any recompletion, workover or conversion of a well requires filing of ACO-2 within 120 days from commencement date of such work.

All requirements of the statutes, rules and regulations promulgated to regulate the oil and gas industry have been fully complied with and the statements herein are complete and correct to the best of my knowledge.

Signature [Signature]

Title Vice President Date 3-22-91

Subscribed and sworn to before me this 22 day of March, 91.

Notary Public Betty M. Abbott

My Commission Expires 3-22-91

STATE OF KANSAS

My Appt. Exp. 1-2-295

K.C.C. OFFICE USE ONLY

F ☒ Letter of Confidentiality Attached
C ☒ Wireline Log Received
C ☒ Drillers Timelog Received

Distribution

☒ KCC ☐ SWD/Rep ☐ NGPA
☒ KGS ☐ Plug ☐ Other (Specify) 15