


Tenny

Form 51-5M-2-29-84703

Map No. KANSAS Sec. 13 Twp. 23 R. 30^W

Well No. 1- Wells Farm National Refg Company

NORTH

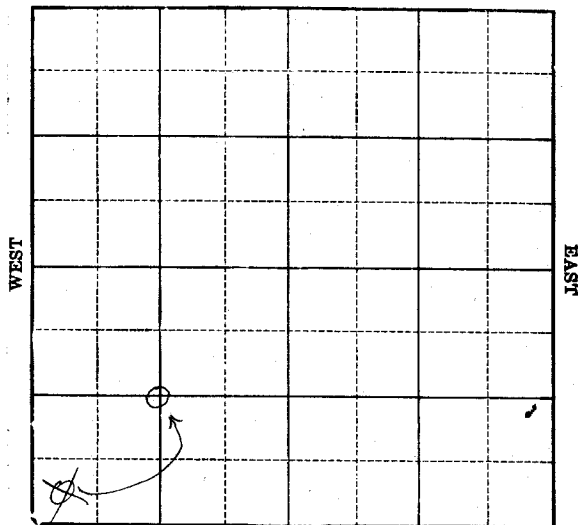

SOUTH

Location
Drilling Remarks

Rig Up
Drilling Remarks

2027

RECORD

PRODUCTION

Cased _____ in. _____ ft.
Sand _____
Gas _____
Oil _____
Total Depth _____

1st 24 hrs. Nat. _____
1st 24 hrs. after shot _____
Gas _____ cu. ft. _____
Dry Hole _____
Abandoned _____

Tenny
Form 242A-5M-8-30-1901

Map No. KANSAS Sec. 13 Twp. 23 R. 30^W

Well No. 1- Wells Farm National Refg Company

NORTH

Ft. from N. Line

1320

Ft. from S. Line

330


Ft. from E. Line

1320

Ft. from W. Line

330

1931

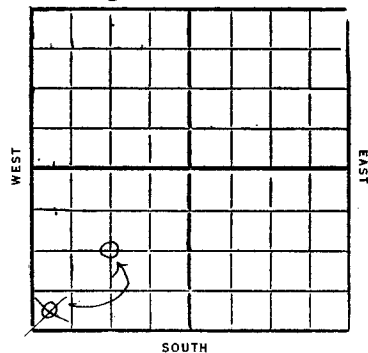

SOUTH

Date

REPORT

8/26 *Rob*
9/2 *Wig*
9/19 *Spdg*
9/16 *Rem 20"-505*
9/23 *Dreg 495*
9/30 *20"-625*
15 1/2"-1103
dreg 1105
10/7 *" 1365'*
10/14 *15"-1386*
dreg 1470
10/21 *UHP 15"-1500'*
10/28 *dreg 1610'*
11/4 *" 1680'*
11/10 *" 1800'*
11/18 *13"-1866*
Dreg 1910'
11/24 *Rem 13"-2015*
SD 2030'
12/2 *SD 2100'*
12/9 *13"-2076*
dreg 2300'

2/16- Dreg 2600'
 2/22- " 2828'
 2/30- " 3225'
 1932
 1/6- " 3400'
 1/3- Small sho gas 3300
 10"- 3320
 3 bailer water 3365
 Hole caving at 3500
 Will run 8" csg
 1/20- Dreg 3610'
 1/27- " 3750'
 2/3- 8"- 3765
 SD 3805' repairs
 2/10- —
 2/17- —
 2/26- Dreg 3900'
 3/2- UIR 8"- 3965'
 3/9- Dreg 4100'
 3/16- No report
 3/22- Dreg 4425'
 3/30- 8"- 4215' (?)
 (Refuse to give correct dope)
 4/6- UIR 8"- 4310'
 4/13- 8"- 4450
 dreg 4505
 4/20- UIR 8 1/4"- 4550'
 4/27- Dreg 4700'
 5/4- T.D. 4755' Ring 6"
 5/11- 6"- 4770
 Dreg 4800'

FORM 22A-5M-8-30-PETROL

Map No. Kansas Sec. 13 Twp. 23 R. 30
 Well No. 1- Wells Farm
National Refg Company


_____ Ft. from N. Line

1320 Ft. from S. Line

_____ Ft. from E. Line

1320 Ft. from W. Line

1932

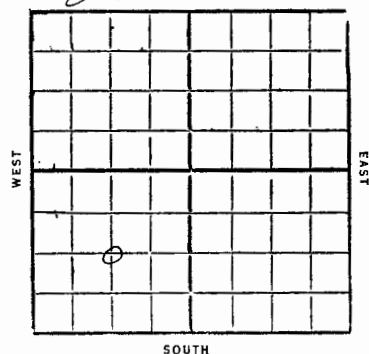

Date

REPORT

5/18	Dreg 4855
5/25	" 4985
6/1	UIR 6"- 5080'
6/8	—
6/15	—
6/22	6"- 5040
	Dreg 5140'
6/29	No report
7/6	T.D. 5140' UIR 6"
7/13	—
7/20	6"- 5120
	dreg 5340'
7/27	Base line 5300
	dreg 5440' shale
8/3	" 5480'
8/10	" 5545'
8/17	" 5630'
8/24	" 5740'
8/31	" 5820'
9/7	SD 5872'
9/14	—
9/21	—

9/30- SD 5872
10/5- TD 5872
Dry & Abandoned

Form 26-1M Bks-9-28

Finnely

Map No. **KANSAS**

Sec. *13*

Twp. *23*

R. *30* W

Well No. *1* *Wells*

National Regg Co Company

Contractor

FIRST REPORTS

SECTION PLAT

.....Ft. from N. Line

330Ft. from S. Line

.....Ft. from E. Line

330Ft. from W. Line

Location.....

Rig up.....

Drilling and Remarks:

RECORD

Cased.....in.,ft.

Sand.....

Gas.....

Oil.....

Total Depth.....

PRODUCTION

1st 24 hrs. Nat.....

1st 24 hrs. after shot.....

Gas.....Cu. Ft.

Dry Hole.....

Abandoned.....

Date

AUG 26 1931

CHAS. L. SHERWOOD

.....192.....Scout

Finney

Map No. KANSAS Sec. 13 Twp. 23 R. 30 WWell No. 1 WellsNational Regg Co Company

Contractor


CORRECTION

SECTION PLAT

Ft. from N. Line

1320 Ft. from S. Line

Ft. from E. Line

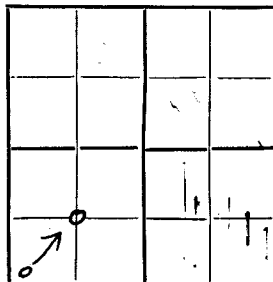1320 Ft. from W. Line

Location.....

Rig up.....

Drilling and Remarks:

RECORD

Cased.....in.,ft.

Sand.....

Gas.....

Oil.....

Total Depth.....

PRODUCTION

1st 24 hrs. Nat.....

1st 24 hrs. after shot.....

Gas.....Cu. Ft.

Dry Hole.....

Abandoned.....

Date

SEP 9 1931

CHAS. L. SHERWOOD

192

Scout

Finney

Map No. KANSAS Sec. 13 Twp. 23 R. 30 WWell No. 1 WellsNational Regg Co Company

Contractor


CORRECTION

SECTION PLAT

Ft. from N. Line

1320 Ft. from S. Line

Ft. from E. Line

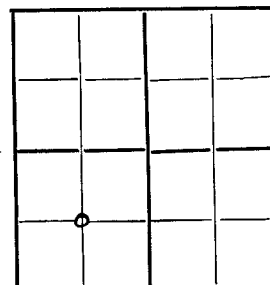1320 Ft. from W. Line

Location.....

Rig up.....

Drilling and Remarks:

RECORD

Cased.....in.,ft.

Sand.....

Gas.....

Oil.....

Total Depth 5872

PRODUCTION

1st 24 hrs. Nat.....

1st 24 hrs. after shot.....

Gas.....Cu. Ft.

Dry Hole.....✓

Abandoned.....✓

Date

SEP 9 1932

CHAS. L. SHERWOOD

192

Scout