


Harvey

KANSAS

Section 30 Township 23 Range 3-W


Well No. 1 Mollie Devine

Company J.W. Davisson et al
~~T.P. Henry et al~~

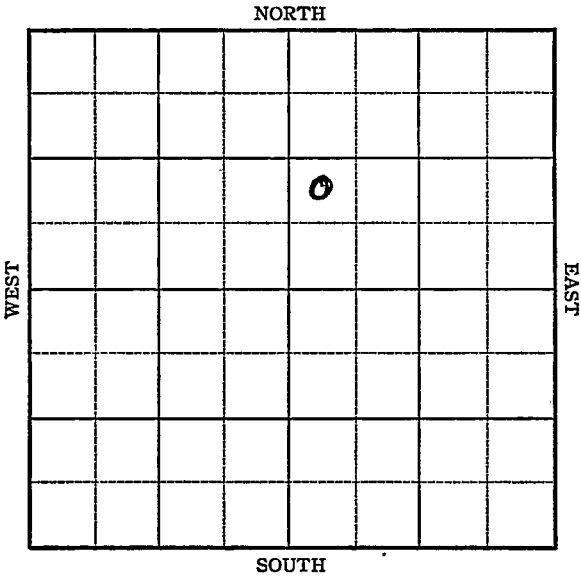

Sec. 30 Twp. 23 R. 3-WWell No. #1 Mollie Devine Farm
J. W. Davisson et al
J. P. Henry et al Company Ft. from N. Line741
990 Ft. from S. Line Ft. from E. Line330 Ft. from W. Line

Elev. 1455

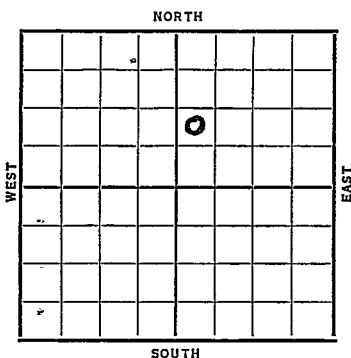

Date	REPORT
1937	
10/6	Cellar.
10/15	"
10/22	R. R.
10/29	R U R
11/5	12" @ 243'. Drlg. 625'.
11/12	Drlg. 1934'.
11/19	Drlg. 2560'.
11/26	Chat 3264' T.D. Rng. 7".
	No shows.
12/3	" "
12/10	" "
12/17	7" @ 3264'. WOG.
12/24	" " "
12/31	" " "
1938	
1/7	" " "
1/14	5" @ 3265'. 100,000 gas. @
	3290'. T.D. 3331' S.O.
	Fsg. bit.
1/20	T.D. 3331' S.D.

OVER

1938

1/28 T.D. 3356' 1600' oil 2 hrs.

2/4 2000 Acid.

2/9 5" @ 3265'.

Chat 3264'.

T.D. 3356'.

2000 acid.

Potential 753 bbls.


15 wbls. water in 8 hrs.

COMPLETED

Harvey KANSAS

Map No. _____ Sec. 30 Twp. 23 R. 3WWell No. 1 Mollie DevineT P Henry et al CompanyFIRST REPORT Contractor

SECTION PLAT

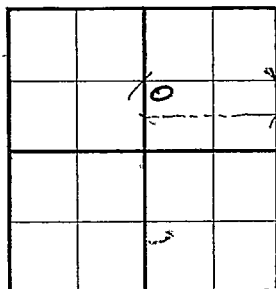NW SW NE
Ft. from N. Line990 Ft. from S. Line

Ft. from E. Line

330 Ft. from W. Line

Location _____

Rig up _____

Drilling and Remarks:

Cellar

RECORD

Cased _____ in., _____ ft.

Sand _____

Gas _____

Oil _____

Total Depth _____

PRODUCTION

1st 24 hrs. Nat. _____

1st 24 hrs. after shot _____

Gas _____ Cu. Ft.

Dry Hole _____

Abandoned _____

Date

OCT - 6 1937 19H. D. Hatfield Scout

Harvey KANSAS

Map No. 39 Sec. 30 Twp. 23 R. 3 WWell No. 1- Mollie DevineT. P. Henry et al Company

Contractor

CORRECTION

N W S W N E

 Ft. from N. Line741 Ft. from S. Line Ft. from E. Line330 Ft. from W. Line

SECTION PLAT

		0	

CORRECTION

Location Rig up

Drilling and Remarks:

foot measurements
were first reported
as 990' x 330'

RECORD

Cased in., ft.Sand Gas Oil Total Depth

PRODUCTION

1st 24 hrs. Nat. 1st 24 hrs. after shot Gas Cu. Ft.Dry Hole Abandoned

Date

OCT 13 1937


19

H. D. Hatfield

Scout

Harvey **KANSAS**Map No. _____ Sec. 30 Twp. 23 R. 3WWell No. 1- Mollie DevineJ. W. Harrison et al Company

Contractor

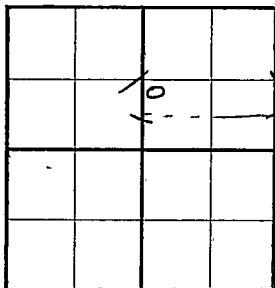CORRECTION**SECTION PLAT**

_____ Ft. from N. Line

741 Ft. from S. Line

_____ Ft. from E. Line

330 Ft. from W. Line

Location _____

RECORD

Cased _____ in., _____ ft.

Rig up _____

Sand _____

Drilling and Remarks:

Gas _____

Oil _____

Total Depth _____

PRODUCTION

1st 24 hrs. Nat. _____

1st 24 hrs. after shot _____

Gas _____ Cu. Ft.

Dry Hole _____

Abandoned _____

Date

NOV 17 1937 19E. D. Hatfield

Scout

Harvey KANSAS

Map No. 39 Sec. 30 Twp. 23 R. 3WWell No. 1 Mollie DevineJ. W. Davisson et al Company

Contractor

COMPLETED

NW SW NE

Ft. from N. Line

741 Ft. from S. Line

Ft. from E. Line

330 Ft. from W. Line

SECTION PLAT

		0	

Location _____

Rig up _____

Drilling and Remarks:

*2000 cu. ft.**POT 723**15 bbls wtr in 8 hrs*

RECORD

Cased 7 in., 3265 ft.Sand Chat 3264

Gas _____

Oil _____

Total Depth 3356

PRODUCTION

1st 24 hrs. Nat. _____

1st 24 hrs. after shot _____

Gas _____ Cu. Ft.

Dry Hole _____

Abandoned _____

Date

FEB 9 1938

19

H. D. Hatfield

Scout