
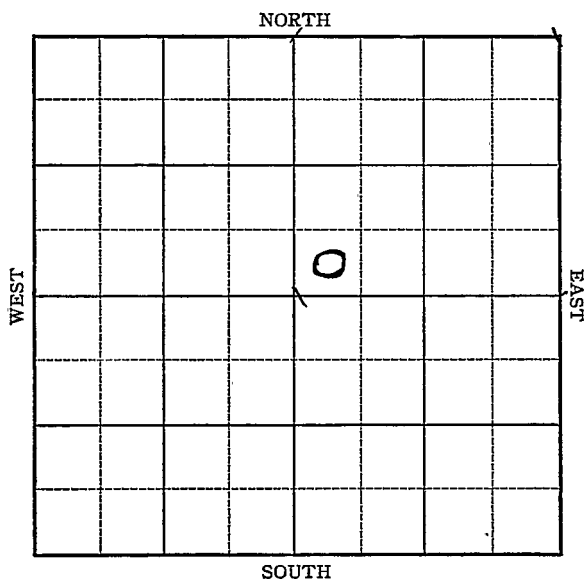


Section 30 Township 23 Range 3-WWell No. 1 - JeromeCompany Derby Oil

Sec. 30 Twp. 23 R. 3-WWell No. #1 Jerome FarmDerby Oil Company Ft. from N. Line248 Ft. from S. Line Ft. from E. Line338 Ft. from W. Line

Elev. 1456

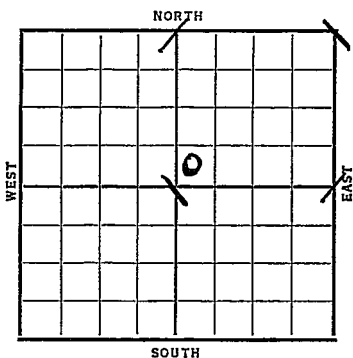

Date	REPORT
1937	
9/1	B.R.R.
9/10	R U R
9/17	12" @ 249'. WOC.
9/24	Drlg. 1080'.
10/2	Drlg. 2685'.
10/8	Chat 3262'. 6" @ 3264'.
	T.D. 3269'. No shows. WOC.
10/15	Drlg. 3294' No shows.
10/22	T.D. 3359'. Pump 43 B.O. & 5
	B.W. 13 hrs. 2000 acid.
10/29	Flowed 98 bbls. oil & 20 bbls.
	water in 8 hrs. 2000 acid.
11/3	6" @ 3264'.
	Chat 3262'.
	T.D. 3359'.
	2000 acid.
	Potential 461 bbls. Flowing.
	S.W.
	COMPLETED

Harvey

Map No. _____ Sec. 30 Twp. 23 R. 3w

Well No. 1-Jerome

Derby Oil Company

Contractor _____

FIRST REPORT

SECTION PLAT

_____ Ft. from N. Line

248 Ft. from S. Line

_____ Ft. from E. Line

338 Ft. from W. Line

Location _____

Rig up _____

Drilling and Remarks:

B.P.R.

RECORD

Cased _____ in., _____ ft.

Sand _____

Gas _____

Oil _____

Total Depth _____

PRODUCTION

1st 24 hrs. Nat. _____

1st 24 hrs. after shot _____

Gas _____ Cu. Ft.

Dry Hole _____

Abandoned _____

Date

SEP 1 1937

H. D. Hatfield Scout

KANSAS

Harvey

Map No. 39 Sec. 30 Twp. 23 SWWell No. 1 Jerome

Derby

Company

Contractor

COMPLETED
SW NE Ft. from N. Line248 Ft. from S. Line Ft. from E. Line338 Ft. from W. Line

SECTION PLAT

		0	

Location Rig up

Drilling and Remarks:

2000 Acid.POT-461 Flowing
SW

RECORD

Cased 6 in. 3264 ft.Sand CHAT 3262Gas Oil Total Depth 3359

PRODUCTION

1st 24 hrs. Nat. 1st 24 hrs. after shot Gas Cu. Ft.Dry Hole Abandoned

Date

NOV 3 1937 19

H. D. Hatfield Scout