


Section.....30.....Township.....23.....Range.....3-<sup>W</sup>

Well Number.....1 - Murphy.....

Company.....Olson Oil &amp; Lario.....

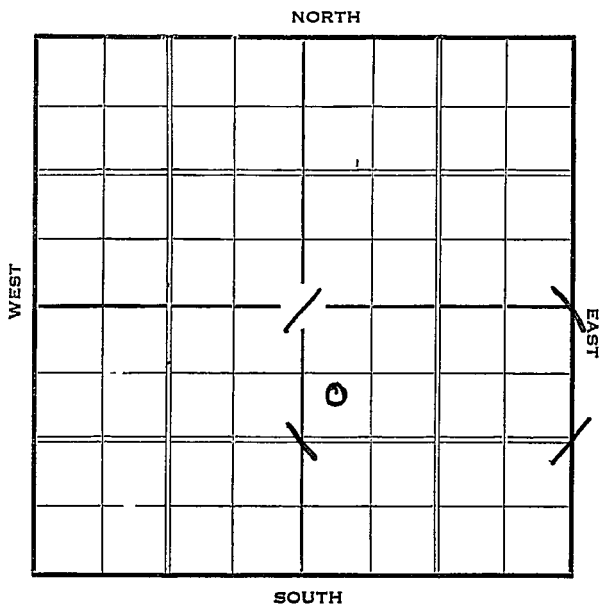


Sec. 30 Twp. 23 R. 3-WWell No. #1 Murphy FarmOlsen Oil & Lario Company1048  
~~725~~ Ft. from N. Line

Ft. from S. Line

Ft. from E. Line

330 Ft. from W. Line

Elev. 1458

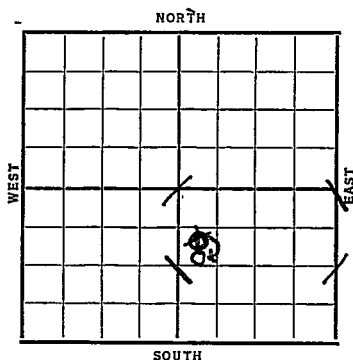

| Date | REPORT                    |
|------|---------------------------|
| 1937 |                           |
| 5/12 | Rig'n Rot.                |
| 5/21 | 12" @ 260'. Drlg. 1050'.  |
| 5/28 | " " " "                   |
| 6/4  | Chat 3272'. T.D. 3287'.   |
|      | RUST.                     |
| 6/11 | T.D. 3361'. H.F.O.        |
|      | Flowed 15 bbls.           |
|      |                           |
|      |                           |
| 6/16 | 7" @ 3287'.               |
|      | Chat 3272'.               |
|      | T.D. 3361'.               |
|      | Pump 81 bbls. 24 hrs Nat. |
|      | 2000 acid.                |
|      | Pot. 454 bbls. 24 hrs.    |
|      | 11% water.                |
|      |                           |
|      | <b>COMPLETED</b>          |
|      |                           |
|      |                           |
|      |                           |

Harvey KANSAS

Map No. 39 Sec. 30 Twp. 23 R. 3 WWell No. 1-MurphyOlson Oil & Lario Company

Contractor

## FIRST REPORT

## SECTION PLAT

|  |  |   |  |
|--|--|---|--|
|  |  |   |  |
|  |  |   |  |
|  |  | 0 |  |
|  |  |   |  |

728 Ft. from N. Line1942 Ft. from S. Line77 Ft. from E. Line330 Ft. from W. Line

Location \_\_\_\_\_

Rig up \_\_\_\_\_

Drilling and Remarks:

Rign Rot.

## RECORD

Cased \_\_\_\_\_ in., \_\_\_\_\_ ft.

Sand \_\_\_\_\_

Gas \_\_\_\_\_

Oil \_\_\_\_\_

Total Depth \_\_\_\_\_

## PRODUCTION

1st 24 hrs. Nat. \_\_\_\_\_

1st 24 hrs. after shot \_\_\_\_\_

Gas \_\_\_\_\_ Cu. Ft.

Dry Hole \_\_\_\_\_

Abandoned \_\_\_\_\_

Date

MAY 12 1937

19

E. D. Hatfield Scout

*Harvey* KANSAS

Map No. \_\_\_\_\_ Sec. *30* Twp. *23* R. *3 W*

Well No. *1-Murphy*

*Olson Oil & Lario* Company

Contractor \_\_\_\_\_

CORRECTION

*1048* Ft. from N. Line

\_\_\_\_\_ Ft. from S. Line

\_\_\_\_\_ Ft. from E. Line

~~*330*~~ Ft. from W. Line

SECTION PLAT

|  |  |  |  |
|--|--|--|--|
|  |  |  |  |
|  |  |  |  |
|  |  |  |  |
|  |  |  |  |

Location \_\_\_\_\_

Rig up \_\_\_\_\_

Drilling and Remarks:

*first reported  
as 728' from  
north line*

RECORD

Cased \_\_\_\_\_ in., \_\_\_\_\_ ft.

Sand \_\_\_\_\_

Gas \_\_\_\_\_

Oil \_\_\_\_\_

Total Depth \_\_\_\_\_

PRODUCTION

1st 24 hrs. Nat. \_\_\_\_\_

1st 24 hrs. after shot \_\_\_\_\_

Gas \_\_\_\_\_ Cu. Ft.

Dry Hole \_\_\_\_\_

Abandoned \_\_\_\_\_

Date

JUN 16 1937

19

H. D. Hatfield

Scout

Harvey KANSAS

Map No. 39 Sec. 30 Twp. 23 R. 5W

Well No. 1-Murphy

Olson Oil & Lario Company

Contractor

COMPLETED

1048 Ft. from N. Line

\_\_\_\_\_ Ft. from S. Line

\_\_\_\_\_ Ft. from E. Line

330 Ft. from W. Line

SECTION PLAT

|  |  |   |  |
|--|--|---|--|
|  |  |   |  |
|  |  |   |  |
|  |  | 0 |  |
|  |  |   |  |

(see correction Ticket)

Location \_\_\_\_\_

Rig up \_\_\_\_\_

Drilling and Remarks:

Pump 8 1/2 24 nat.

2000 Acid

Pat 45 1/2 24

11 70 water

RECORD

Cased 7 in. 3287 ft.

Sand Chat 3272

Gas \_\_\_\_\_

Oil \_\_\_\_\_

Total Depth 3361

PRODUCTION

1st 24 hrs. Nat. \_\_\_\_\_

1st 24 hrs. after shot \_\_\_\_\_

Gas \_\_\_\_\_ Cu. Ft.

Dry Hole \_\_\_\_\_

Abandoned \_\_\_\_\_

Date

JUN 16 1937 19 H. D. Hatfield Scout