


Harvey

Form 51-5M-11-31-Palace

Map No. KANSAS Sec. 30 Twp. 23 R. 3^w

Well No. 1 - Nelson Farm
Olson & Shell Company

NORTH

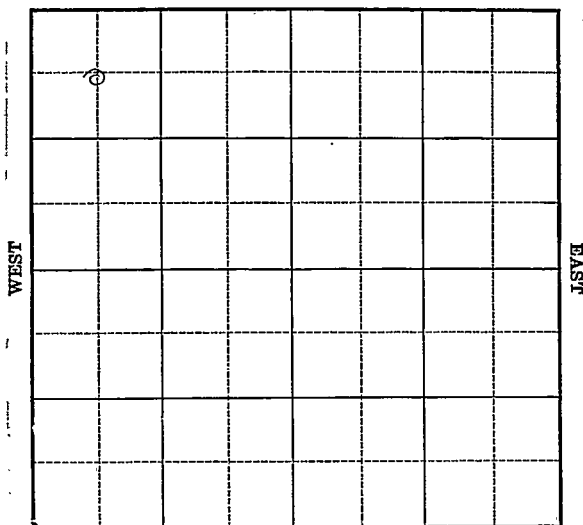

SOUTH

Location

Drilling Remarks

Rig Up

Drilling Remarks

RECORD

Cased in. ft.

Sand

Gas

Oil

Total Depth

PRODUCTION

1st 24 hrs. Nat.

1st 24 hrs. after shot

Gas cu. ft.

Dry Hole

Abandoned

Map No. KANSAS Sec. 30 Twp. 23 R. 3^W

Well No. 1- Nelson Farm
Olsen & Shell Company

NORTH


683 Ft. from N. Line

_____ Ft. from S. Line

_____ Ft. from E. Line

660 Ft. from W. Line

1932

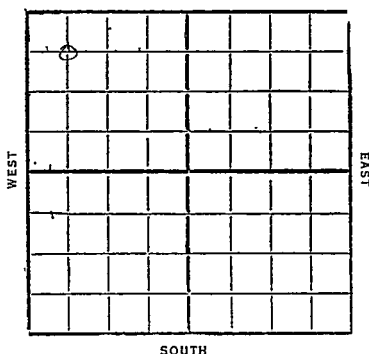

Date

REPORT

Date	REPORT
7/27	Ry
8/3	Cem 12"-260
8/10	Wire 1425'
8/17	" 2350'
8/24	" 3111'
8/31	Top Chat 3271 Cem 8"-3288 SID 3300'
9/7	TD 3371 Est 20 bbl oil per hr and 3 M gas
9/14	Cased 8"-3288 Chat Chat 3271-3371 TD 3371 flow 552 bbl 24 hr 4,800,000 cu ft gas 38° grav at 90 Comp.

Harvey

39 KANSAS Sec. 30 Twp. 23 R. 3^W
 Map No. _____
 Well No. 1 *Nelson*
Olsen & Shell Company

Contractor

FIRST REPORTS

SECTION PLAT

0			

683 Ft. from N. Line

_____ Ft. from S. Line

_____ Ft. from E. Line

660 Ft. from W. Line

Location _____

Rig up ☒

Drilling and Remarks:

RECORD

Cased _____ in., _____ ft.

Sand _____

Gas _____

Oil _____

Total Depth _____

PRODUCTION

1st 24 hrs. Nat. _____

1st 24 hrs. after shot _____

Gas _____ Cu. Ft.

Dry Hole _____

Abandoned _____

Date

JUL 27 1932

192 CHAS. L. SHERWOOD
Scout

39 KANSAS

Harvey

Map No. _____ Sec. 30 Twp. 23 R. 3^W

Well No. 1 Nelson

Olsen & Shee Company

Contractor

COMPLETED

683 Ft. from N. Line

_____ Ft. from S. Line

_____ Ft. from E. Line

660 Ft. from W. Line

SECTION PLAT

0			

Location _____

Rig up _____

Drilling and Remarks:

Flow 552 Bl

24 hours.

38 Gas at 90

RECORD

Cased 8 in., 3288 ft.

Sand Chat 3271-3371

Gas _____

Oil _____

Total Depth 3371

PRODUCTION

1st 24 hrs. Nat. _____

1st 24 hrs. after shot _____

Gas 4,800,000 Cu. Ft.

Dry Hole _____

Abandoned _____

Date

SEP 1 1932

CHAS. L. SHERWOOD

192 Scout