


Map No. KANSAS Sec. 30 Twp. 23 R. 3W
 Well No. 2-Nelson Farm
Olson & Shell Company

NORTH

WEST

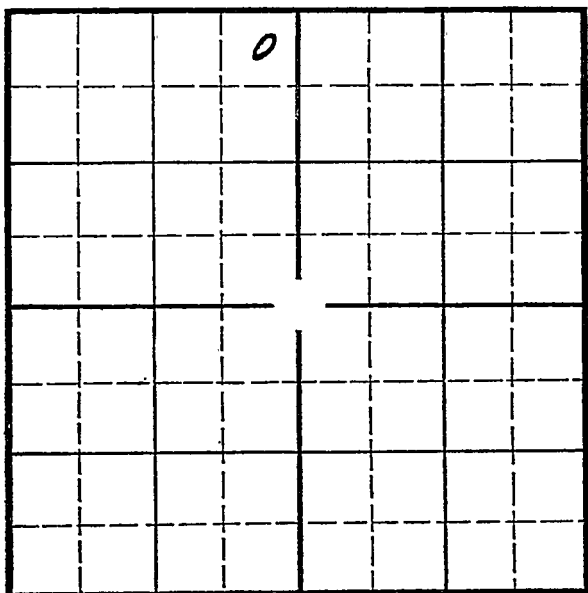

SOUTH

Location _____

Drilling Remarks _____

Rig Up _____

Drilling Remarks _____

RECORD

Cased _____ in. _____ ft.

Sand _____

Gas _____

Oil _____

Total Depth _____

PRODUCTION

1st 24 hrs. Nat. _____

1st 24 hrs. after shot _____

Gas _____ cu. ft. _____

Dry Hole _____

Abandoned _____

Map No. KANSAS Sec. 30 Twp. 23 R. 3W
Well No. 2-Nelson Farm
Olson & Shell Company


330 Ft. from N. Line

 Ft. from S. Line

330 Ft. from E. Line

 Ft. from W. Line

Elev. 1460

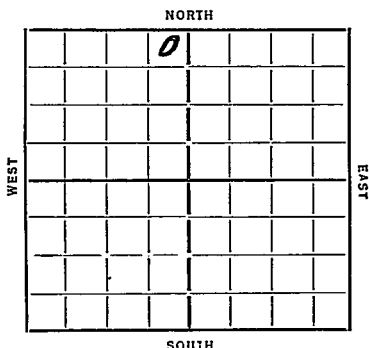

Date	REPORT
1935	
6/5	Cellar
6/13	Rig
6/20	Alg 1109 15" 237
6/28	" 2602
7/3	" 3118
7/11	TC 3256 7" 3269 Rust
7/18	T7 3370 Tubg
7/24	flow by head
	Chat 3256
	T7 3370
	flow 305 Oil
	50 Water

COMPLETED

KANSAS

Map No. 39 Sec. 30 Twp. 23 R. 3WWell No. 2- NelsonOlsen & Still Company

Contractor

SECTION PLAT

	0		

330 Ft. from N. Line

Ft. from S. Line

330 Ft. from E. Line

Ft. from W. Line

Location

Rig up

Drilling and Remarks:

cellar

RECORD

Cased.....in.,ft.

Sand.....

Gas.....

Oil.....

Total Depth.....

PRODUCTION

1st 24 hrs. Nat.....

1st 24 hrs. after shot.....

Gas.....Cu. Ft.

Dry Hole.....

Abandoned.....

Date

ORVAL MANNSCHRECK

6-5-35

192

Scout

Map No. 39 Sec. 30 Twp. 23 R. 3WWell No. 2 NelsonOlsen & Shell Company

Contractor

CORRELATED

SECTION PLAT

		0	

330 Ft. from N. Line

..... Ft. from S. Line

330 Ft. from E. Line

..... Ft. from W. Line

Location.....

Rig up.....

Drilling and Remarks:

Ck 8.3256Flow
305 oil
50 water

RECORD

Cased.....in.,ft.

Sand.....

Gas.....

Oil.....

Total Depth. 3320

PRODUCTION

1st 24 hrs. Nat.

1st 24 hrs. after shot.....

Gas.....Cu. Ft.

Dry Hole.....

Abandoned.....

Date

ORVAL MANNSCHRECK

7/24/35 192.....

Scout