


Section 30 Township 23 Range ~~24~~ 3W

Well Number #1 Murphy

Company Tom Palmer

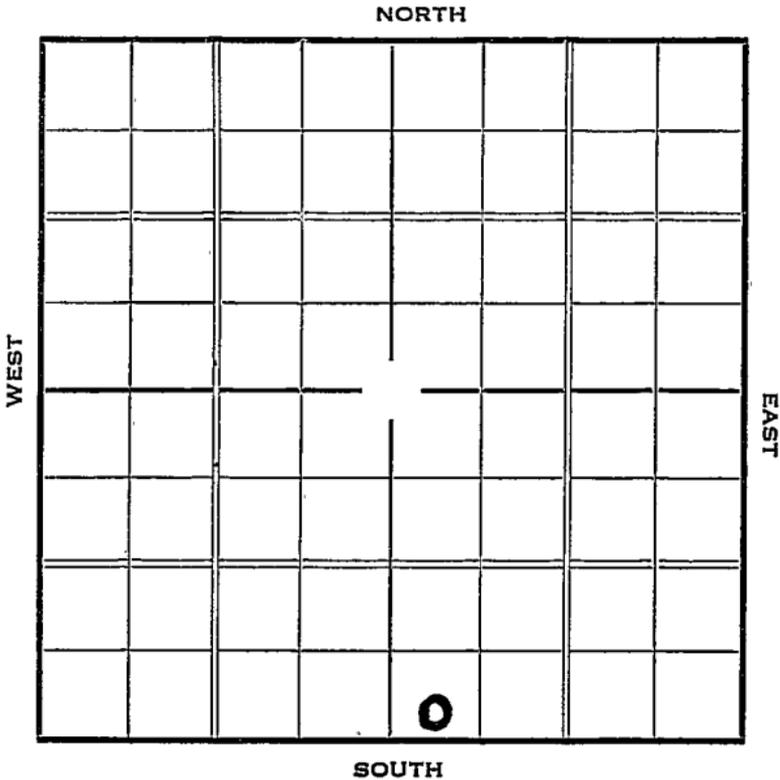

Sec. 30 Twp. 23 R. 3-W

Well No. #1 Murphy Farm


Tom Palmer Company

 Ft. from N. Line

270' Ft. from S. Line

 Ft. from E. Line

330' Ft. from W. Line

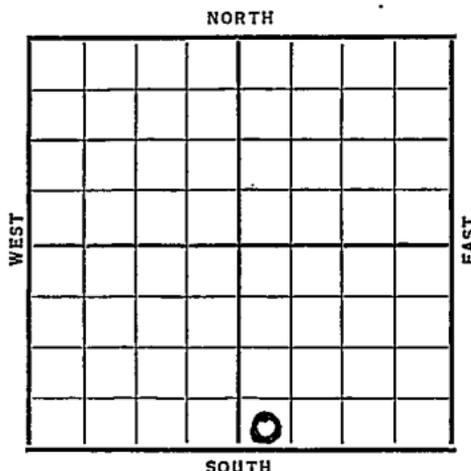

Date	REPORT
1937	
7/7	D1g. 2615'
7/16	10" @ 265'. Chat 3260'.
	T.D. 3299'. 7" @ 3290'. WOG.
7/23	1st oil 3303-5'.
	Drlg. 3333'. 400' oil.
7/28	7" @ 3290'
	Chat 3272' (corrected)
	TD 3361' (S.W.)
	PB 3357' (S.W.)
	3000 acid
	Pot. 316 oil. W/S.W.
	Pumped & flowed
	COMPLETED

Harvey KANSAS

Map No. _____ Sec. 30 Twp. 23 R. 3 W

Well No. 1 - Murphy

Tom Palmer Company

Contractor _____

FIRST REPT

SECTION PLAT

_____ Ft. from N. Line

270 Ft. from S. Line

_____ Ft. from E. Line

330 Ft. from W. Line

		0	

Location _____

Rig up _____

Drilling and Remarks:

Dlg 2615

RECORD

Cased _____ in., _____ ft.

Sand _____

Gas _____

Oil _____

Total Depth _____

PRODUCTION

1st 24 hrs. Nat. _____

1st 24 hrs. after shot _____

Gas _____ Cu. Ft.

Dry Hole _____

Abandoned _____

Date

JUL 7 1937

19

H. D. Hatfield

Scout

Harvey KANSAS

Map No. 39 Sec. 30 Twp. 23 R. 3WWell No. 1 - MurphyTom Palmer Company

Contractor

COMPLETED

SECTION PLAT

 Ft. from N. Line270 Ft. from S. Line Ft. from E. Line530 Ft. from W. Line

		0	

Location Rig up

Drilling and Remarks:

P.B. 33573000 Acidpat - 316 oilw/s.w.Pumped & flowed

RECORD

Cased 7 in., 3290 ft.Sand chat 3272Gas (Corrected)Oil Total Depth 5361 (sw)

PRODUCTION

1st 24 hrs. Nat. 1st 24 hrs. after shot Gas Cu. Ft.Dry Hole Abandoned

Date

JUL 28 1917

H. D. Hatfield

Scout