


Section 30 Township 23 Range 3-W


Well Number 5 - Nelson

Company Olson Oil

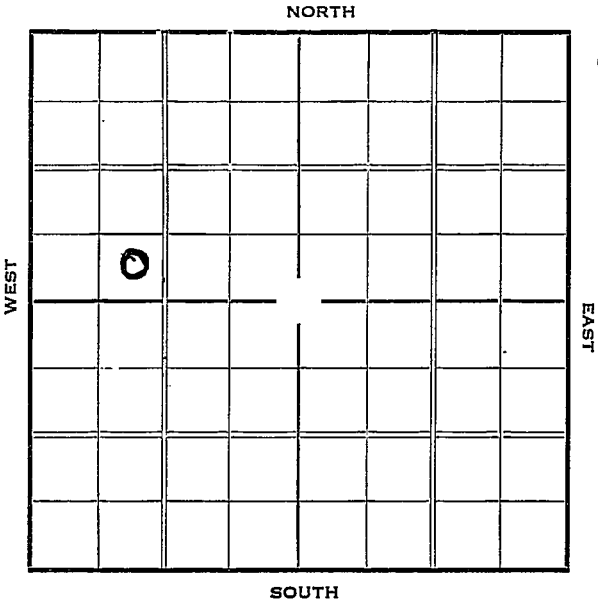

Sec. 30 Twp. 23 R. 3-WWell No. #5 Nelson FarmOlson Oil Company Ft. from N. Line330 Ft. from S. Line Ft. from E. Line990 Ft. from W. Line

Elev. 1459

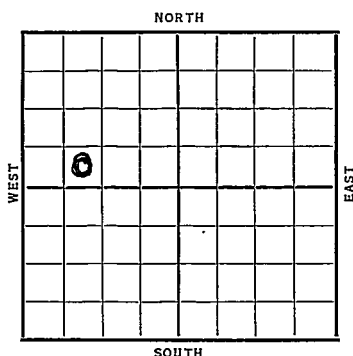

Date

REPORT

1937

5/26

Cellar

6/4

B. R.

6/11

12" @ 252'. Drlg. 847'.

6/19

Drlg. 2377'.

6/25

Drlg. 3225'.

7/2

Chat 3280'. 7" @ 3301'.

T.D. 3365'. SDO

7/9

" " "

7/14

7" @ 3301'.

Chat 3280'.

T.D. 3365'.

2000 acid.

Pot. 866 bbls. Flowing.

COMPLETED

KANSAS

Map No. 39 Sec. 30 Twp. 23 R. 3WWell No. 5-NelsonOlson Oil Company

Contractor

FIRST REPORT

SECTION PLAT

0			

Ft. from N. Line

330 Ft. from S. Line

Ft. from E. Line

990 Ft. from W. Line

Location _____

Rig up _____

Drilling and Remarks:

Cellar

RECORD

Cased _____ in., _____ ft.

Sand _____

Gas _____

Oil _____

Total Depth _____

PRODUCTION

1st 24 hrs. Nat. _____

1st 24 hrs. after shot _____

Gas _____ Cu. Ft.

Dry Hole _____

Abandoned _____

Date

MAY 26 1937 19 H. D. Hatfield Scout

Map No. _____ Sec. 30 Twp. 23 R. 3WWell No. 5- NelsonNelson Oil

Company

Contractor

COMPLETED

SECTION PLAT

_____ Ft. from N. Line

330 Ft. from S. Line

_____ Ft. from E. Line

990 Ft. from W. Line

Location _____

Rig up _____

Drilling and Remarks:

2000 AcidPat - 866Flowing

RECORD

Cased 7 in., 3301 ft.Sand Chat 3280

Gas _____

Oil 1/4Total Depth 3365

PRODUCTION

1st 24 hrs. Nat. _____

1st 24 hrs. after shot _____

Gas _____ Cu. Ft.

Dry Hole _____

Abandoned _____

Date

JUL 14 1937H. D. Hatfield

Scout