


Harvey

KANSAS

Section 30 Township 23 Range 3-W

Well Number 2 Norris

Company Hipple et al

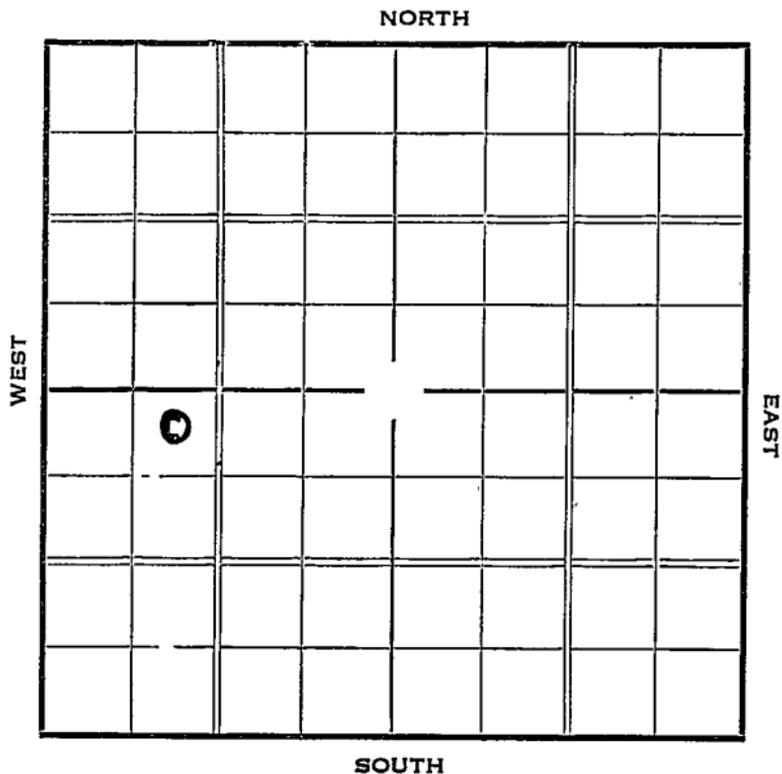

Sec. 30 Twp. 23 R. 3-W

Well No. #2 Norris Farm
Hipple et al Company


330 Ft. from N. Line

_____ Ft. from S. Line

_____ Ft. from E. Line

990 Ft. from W. Line

Elev. 1463

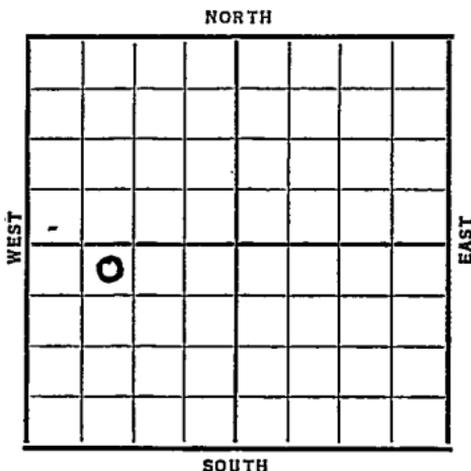

Date	REPORT
1937	
5/12	Location
5/21	Cellar
5/28	Rig
6/4	13" @ 275'. WOC.
6/11	Drlg. 2550'.
6/19	Chat 3275'. 7" @ 3283'.
6/25	RUST.
7/2	" " " " " "
7/7	T.D. 3373'. 2000 acid.
7/7	7" @ 3283'.
7/7	Chat 3275'.
7/7	T.D. 3373'.
7/7	2000 A.
7/7	Pot. 967 bbls, Flowing.
	COMPLETED

Harvey KANSAS

Map No. 39 Sec. 30 Twp. 23 R. 3W

Well No. 2-Norris

Hipple et al Company

Contractor

FIRST REPORT

SECTION PLAT

330 Ft. from N. Line

 Ft. from S. Line

 Ft. from E. Line

990 Ft. from W. Line

	0		

Location ✓

Rig up

Drilling and Remarks:

RECORD

Cased in., ft.

Sand

Gas

Oil

Total Depth

PRODUCTION

1st 24 hrs. Nat.

1st 24 hrs. after shot

Gas Cu. Ft.

Dry Hole

Abandoned

Date


19

H. D. Hatfield

Scout

Harvey **KANSAS**

Map No. 39 Sec. 30 Twp. 23R. 34

Well No. 2-Norris

Hipple et al. Company

Contractor

COMPLETE

SECTION PLAT

330 Ft. from N. Line
 _____ Ft. from S. Line
 _____ Ft. from E. Line
990 Ft. from W. Line

	0		

Location _____

Rig up _____

Drilling and Remarks:

2000 A

*POT - 967
 flowing*

RECORD

Cased 7 in., 3283 ft.

Sand CHAT 3275

Gas _____

Oil _____

Total Depth 3373

PRODUCTION

1st 24 hrs. Nat. _____

1st 24 hrs. after shot _____

Gas _____ Cu. Ft.

Dry Hole _____

Abandoned _____

Date

JUL 7 1937₁₉

H. D. Hatfield

Scout