

KANSAS Harvey


Section 30 Township 23 Range 3W

Well No. 4 Norris

Company Lebow & Sohio

Burrton Pool

NORTH

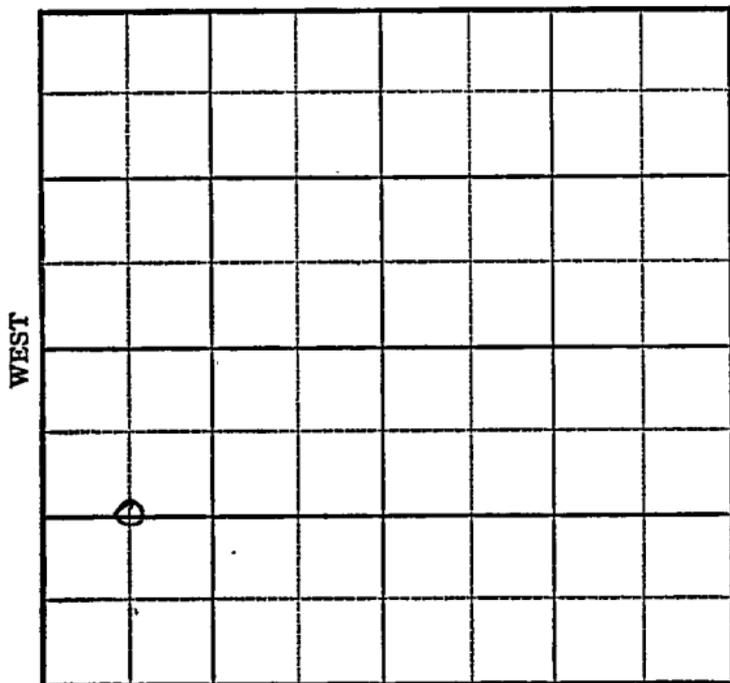

12

SOUTH

Sec. 30 Twp. 23 R. 3W

Well No. 4 Norris Farm

Lebow & Sohio Company

Burrton Pool


1320 Ft. from N. Line

\_\_\_\_\_ Ft. from S. Line

\_\_\_\_\_ Ft. from E. Line

660 Ft. from W. Line

C W  $\frac{1}{2}$  SW

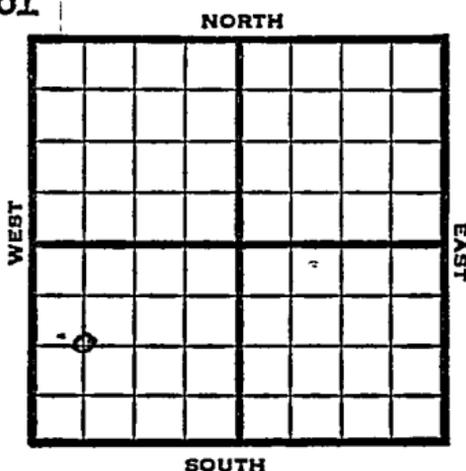

1948

Elev 1458'

REPORT

11/17

Location

11/23

Drlg 850'

11/30

Miss 3277'

TD 3300

5"@ 3290'

12/6

"

12/14

"

12/22

TD 3359'

12/29

TD 3362'

500 acid

800' oil

1949

1/12

TD 3362'

Miss 3277'

5"@ 3290'

2500 acid

Pump 25 oil Pot

39° Gr.

Comp

**COMPLETED**

Map No. \_\_\_\_\_ Sec. 30 Twp. 23 R. 3W

Well No. 4 Norris

Lebow & Sohio Company

FIRST REPORT Contractor

C  $W\frac{1}{2}$  SW


SECTION PLAT

1320 Ft. from N. Line

\_\_\_\_\_ Ft. from S. Line

\_\_\_\_\_ Ft. from E. Line

660 Ft. from W. Line

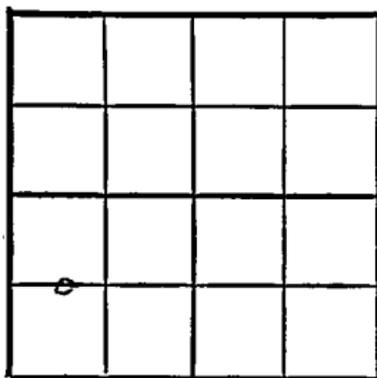

Harvey County

Location X

Rig up \_\_\_\_\_

Drilling and Remarks: \_\_\_\_\_

RECORD

Cased \_\_\_\_\_ in., \_\_\_\_\_ ft.

Sand \_\_\_\_\_

Gas \_\_\_\_\_

Oil \_\_\_\_\_

Total Depth \_\_\_\_\_

PRODUCTION

1st 24 hrs. Nat. \_\_\_\_\_

1st 24 hrs. after shot \_\_\_\_\_

Gas \_\_\_\_\_ Cu. Ft.

Dry Hole \_\_\_\_\_

Abandoned \_\_\_\_\_

Date

NOV 17 1948

19

S. J. LEWIS Scout

Kansas

Map No. 39 Sec. 30 Twp. 23 R. 3W

Well No. 4 Norris

Lebow & Sohio Company

**COMPLETE**

Contractor

C  $W\frac{1}{2}$  SW


*E 11457*  
**SECTION PLAT**

1320 Ft. from N. Line

\_\_\_\_\_ Ft. from S. Line

\_\_\_\_\_ Ft. from E. Line

660 Ft. from W. Line

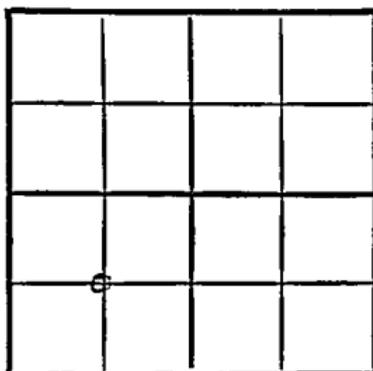

Harvey County

Location \_\_\_\_\_

Rig up \_\_\_\_\_

Drilling and Remarks:

*Miss 3277*  
*5" @ 8290*  
*2500 rods*  
*Pump 25 oil Rod*  
*399 ft*

**RECORD**

Cased \_\_\_\_\_ in., \_\_\_\_\_ ft.

Sand \_\_\_\_\_

Gas \_\_\_\_\_

Oil

Total Depth 3862

**PRODUCTION**

1st 24 hrs. Nat. \_\_\_\_\_

1st 24 hrs. after shot \_\_\_\_\_

Gas \_\_\_\_\_ Cu. Ft.

Dry Hole \_\_\_\_\_

Abandoned \_\_\_\_\_

Date

JAN 12 1949 19

S. J. LEWIS Scout