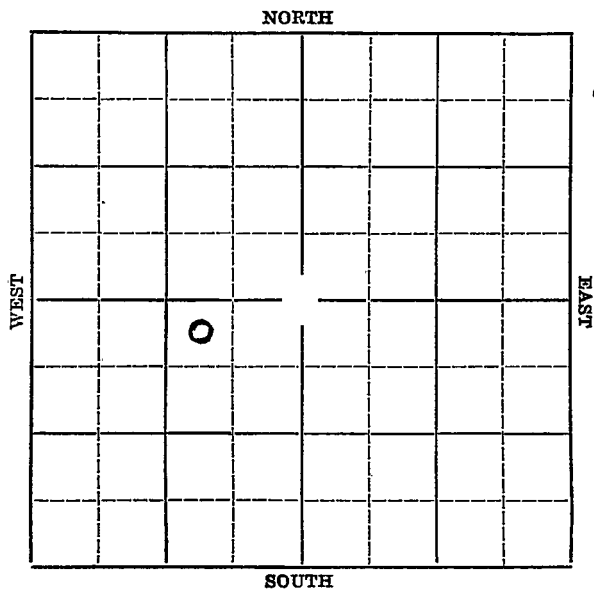



Section 30 Township 23 Range 3-WWell Number 1 SchragCompany Olson & Shell

KANSAS

Harvey

Sec. 30 Twp. 23 R. 3-WWell No. #1 Schrag FarmOlson & Shell Company330 Ft. from N. Line Ft. from S. Line990 Ft. from E. Line Ft. from W. Line

Elev. 1461

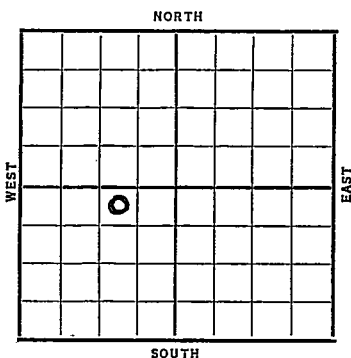

Date	REPORT
1937	
3/17	Location
3/25	Rig
4/2	Rigging up.
4/8	13" @ 248' Drlg. 1247'
4/16	Drlg. 2755'.
4/23	Chat 3290'. 7" @ 3308'. WOC
4/30	T.D. 3366'. Rng. tub.
5/7	Flowed 156 oil 24 hrs.
	Will acidize.
5/12	7" @ 3308'.
	Chat 3290'.
	T.D. 3366'.
	Flowed 156 bbls. 24 hrs. Nat.
	2000 acid.
	Pot. 599 bbls. 24 hrs.
	Flowed.
	COMPLETED

KANSAS *Harvey*Map No. 39 Sec. 30 Twp. 23 R. 34Well No. 1 SchragOlson & Shell Company

Contractor

SECTION PLAT

	o		

330 Ft. from N. Line

_____ Ft. from S. Line

990 Ft. from E. Line

_____ Ft. from W. Line

FIRST REPORT

Location ✓

Rig up _____

Drilling and Remarks:

RECORD

Cased _____ in., _____ ft.

Sand _____

Gas _____

Oil _____

Total Depth _____

PRODUCTION

1st 24 hrs. Nat. _____

1st 24 hrs. after shot _____

Gas _____ Cu. Ft.

Dry Hole _____

Abandoned _____

Date

MAR 17 1937

19

S. J. LEWIS Scout

Harvey **KANSAS**Map No. 39 Sec. 30 Twp. 23 R. 3 WWell No. 1 - SchragOlson & Shell Company

Contractor

COMPLETED**SECTION PLAT**

	0		

330 Ft. from N. Line

_____ Ft. from S. Line

990 Ft. from E. Line

_____ Ft. from W. Line

Location _____

Rig up _____

Drilling and Remarks:

Flowed 156/24 hrs
nat.2000 AcidPOT - 599/24 hrsFlowed ^**RECORD**Cased 7 in., 3308 ft.Sand Chat - 3290

Gas _____

Oil _____

Total Depth 3366**PRODUCTION**

1st 24 hrs. Nat. _____

1st 24 hrs. after shot _____

Gas _____ Cu. Ft.

Dry Hole _____

Abandoned _____

Date

MAY 12 1937 19H. D. Hatfield

Scout