


Section 30 Township 23 Range 3-W

Well Number #2 Schrag

Company Olson Oil

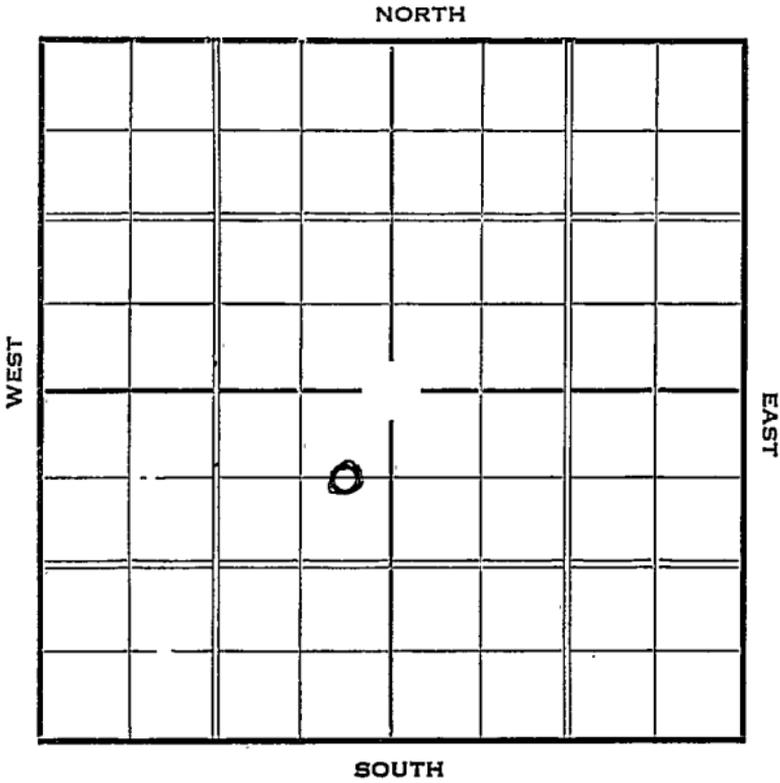

Sec. 30 Twp. 23 R. 3-W

Well No. #2 Schrag Farm

Olson Oil Company


990

~~600~~ Ft. from N. Line

Ft. from S. Line

330 Ft. from E. Line

Ft. from W. Line

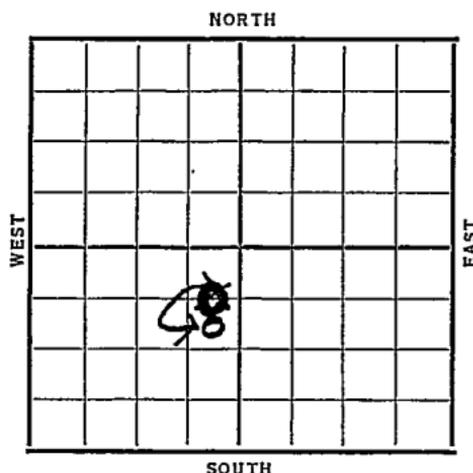

Date	REPORT
1937	
6/30	R.U.R.
7/9	"
7/16	12" @ 252'. Drlg. 2874'.
7/23	Chat 3274'. 7" @ 3291'.
	T.D. 3299'. RUST.
7/30	T.D. 3365'. SD.
8/4	7" @ 3291'.
	Chat 3274'.
	T.D. 3365'.
	1000 acid.
	Pot. 907 bbls.
	COMPLETED

Harvey KANSAS

Map No. \_\_\_\_\_ Sec. 30 Twp. 23 R. 34Well No. 2-SchragOlson Oil Company

Contractor \_\_\_\_\_

## FIRST REPORT

## SECTION PLAT

660 Ft. from N. Line

\_\_\_\_\_ Ft. from S. Line

330 Ft. from E. Line

\_\_\_\_\_ Ft. from W. Line

	0		

Location \_\_\_\_\_

Rig up \_\_\_\_\_

Drilling and Remarks:

R. A. R.

## RECORD

Cased \_\_\_\_\_ in., \_\_\_\_\_ ft.

Sand \_\_\_\_\_

Gas \_\_\_\_\_

Oil \_\_\_\_\_

Total Depth \_\_\_\_\_

## PRODUCTION

1st 24 hrs. Nat. \_\_\_\_\_

1st 24 hrs. after shot \_\_\_\_\_

Gas \_\_\_\_\_ Cu. Ft.

Dry Hole \_\_\_\_\_

Abandoned \_\_\_\_\_

Date

JUN 30 1937

19

H. D. Hatfield Scout

Harvey KANSASMap No. 39 Sec. 30 Twp. 23 R. 3 W.Well No. 2-SchragOlson

Company

Contractor

Correct Location

## SECTION PLAT

COMPLETED

990 Ft. from N. Line

\_\_\_\_\_ Ft. from S. Line

330 Ft. from E. Line

\_\_\_\_\_ Ft. from W. Line


(see Correction Ticket)

Location \_\_\_\_\_

Rig up \_\_\_\_\_

Drilling and Remarks:

1000 acidPat - 907

## RECORD

Cased 7 in., 3291 ft.Sand Chat 3274

Gas \_\_\_\_\_

Oil \_\_\_\_\_

Total Depth 3365

## PRODUCTION

1st 24 hrs. Nat. \_\_\_\_\_

1st 24 hrs. after shot \_\_\_\_\_

Gas \_\_\_\_\_ Cu. Ft.

Dry Hole \_\_\_\_\_

Abandoned \_\_\_\_\_

Date

AUG 4 - 1937

19

H. D. Hatfield Scout