

Harvey


KANSAS

Form 51-5M 5-37 Petrol

Section 30 Township 23 Range 3-W

Well No. #6 J. Schrag Jr.

Company Olson Drlg.

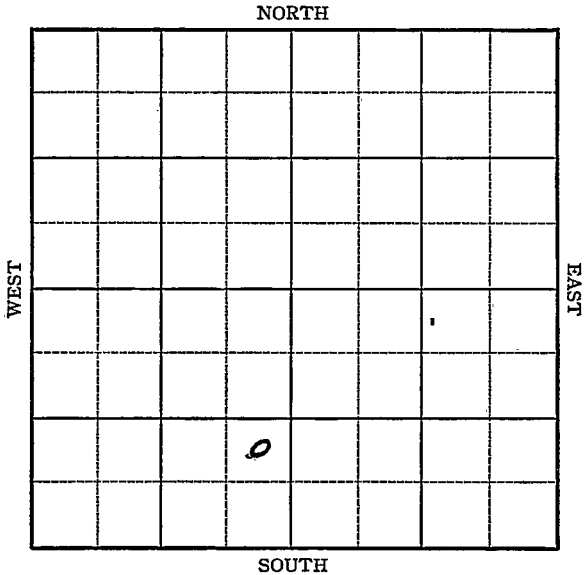

KANSAS

Harvey

Map No. 39 Sec. 30 Twp. 23 R. 3WWell No. 6 J. Schrag Jr.Olson Drlg. Company

Contractor

FIRST REPORT

NE SE SW

SECTION PLAT

	o		

 Ft. from N. Line932 Ft. from S. Line330 Ft. from E. Line Ft. from W. LineLocation Rig up

Drilling and Remarks:

BR

RECORD

Cased in., ft.Sand Gas Oil Total Depth

PRODUCTION

1st 24 hrs. Nat. 1st 24 hrs. after shot Gas Cu. Ft.Dry Hole Abandoned

Date

OCT 27 1937

H. D. Hatfield

