

Harvey


KANSAS

Form 51-5M 5-37 Petrol

Section 30 Township 23 Range 3-W


Well No. #6 Nelson

Company Olson Drlg.

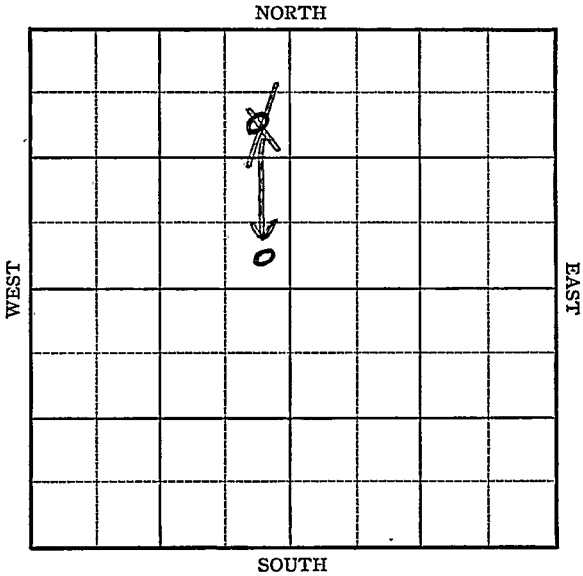

Sec. 30 Twp. 23 R. 3-WWell No. #6 Nelson Farm
Olson Drlg. Company996 Ft. from N. Line330 Ft. from S. Line330 Ft. from E. Line Ft. from W. Line

Elev. 1457

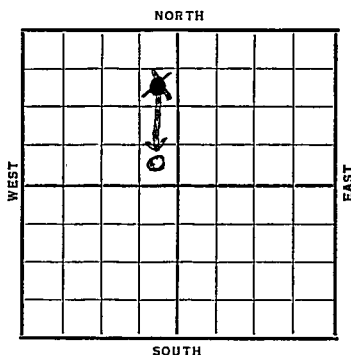

Date	REPORT
1937	
10/27	Location
11/5	B. R. R.
11/12	12" @ 349'. Drlg. 813'.
11/19	Drlg. 2515'.
11/26	Drlg. 3110'.
12/3	Chat 3278', 7" @ 3293'. C.O.
	No shows reported.
12/10	T.D. 3320'. S.O. & W.
12/15	7" @ 3293'.
	Chat 3278'.
	T.D. 3360'.
	1000 acid.
	Potential 341 bbls., flowing.
	COMPLETED

Harvey

KANSAS

Map No. 39 Sec. 30 Twp. 23 R. 3WWell No. 6 NelsonOlson Drlg.

Company

Contractor

FIRST REPORT

SE NE NW

990 Ft. from N. Line Ft. from S. Line330 Ft. from E. Line Ft. from W. Line

SECTION PLAT

	0		

Location XRig up

Drilling and Remarks:

RECORD

Cased in., ft.Sand Gas Oil Total Depth

PRODUCTION

1st 24 hrs. Nat. 1st 24 hrs. after shot Gas Cu. Ft.Dry Hole Abandoned

Date


OCT 27 1937

19

H. D. Hatfield Scout

Harvey **KANSAS**Map No. 39 Sec. 30 Twp. 23 R. 3WWell No. 6-NelsonNelson Drilling Company

Contractor

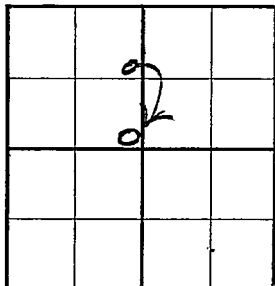CORRECTION**SECTION PLAT** Ft. from N. Line330 Ft. from S. Line330 Ft. from E. Line Ft. from W. LineLocation Rig up

Drilling and Remarks:

Loc. correctedFrom SE NE NWTo SE NW**RECORD**Cased in., ft.Sand Gas Oil Total Depth **PRODUCTION**1st 24 hrs. Nat. 1st 24 hrs. after shot Gas Cu. Ft.Dry Hole Abandoned

Date

NOV 3 1937 19H. D. Hatfield Scout

Harvey

KANSAS

Map No. 37 Sec. 30 Twp. 23 R. 3WWell No. 6 NelsonOlson Drilling

Company

Contractor

COMPLETED

SECTION PLAT

SE NW

 Ft. from N. Line330 Ft. from S. Line330 Ft. from E. Line Ft. from W. Line

Location Rig up

Drilling and Remarks:

1000 acidPOT- 341Flowing

RECORD

Cased 7 in. 3293 ft.Sand Chat 3278Gas Oil Total Depth 3360

PRODUCTION

1st 24 hrs. Nat. 1st 24 hrs. after shot Gas Cu. Ft.Dry Hole Abandoned

Date

DEC 15 1937 19

H. D. Hatfield

Scout