


Harvey

Section 30 Township 23 Range 3-W

Well No. 3 - Norris

Company Carl Hipple

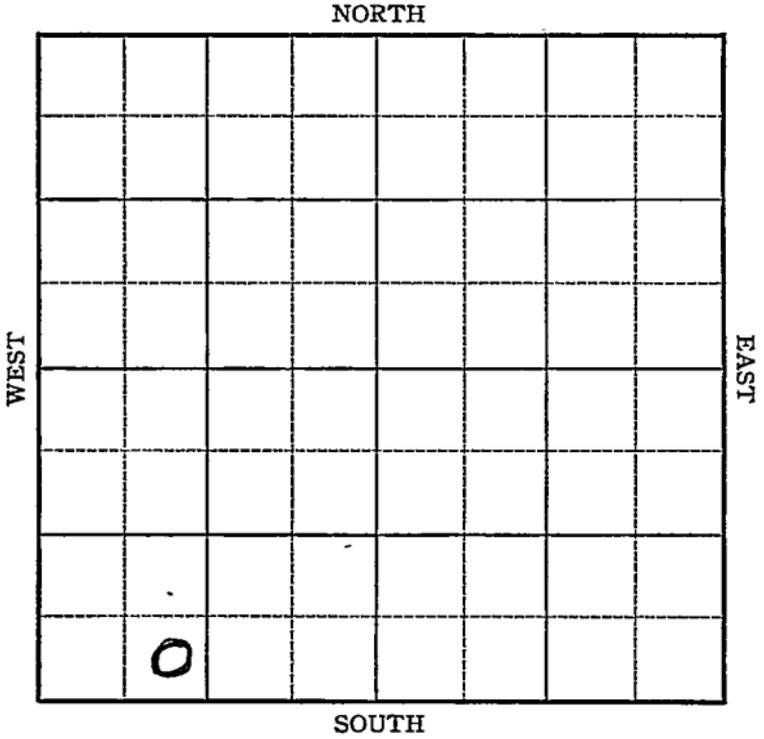

13

0

Sec. 30 Twp. 23 R. 3-W


Well No. #3 Norris Farm
Carl Hipple Company

 Ft. from N. Line

330 Ft. from S. Line

 Ft. from E. Line

990 Ft. from W. Line

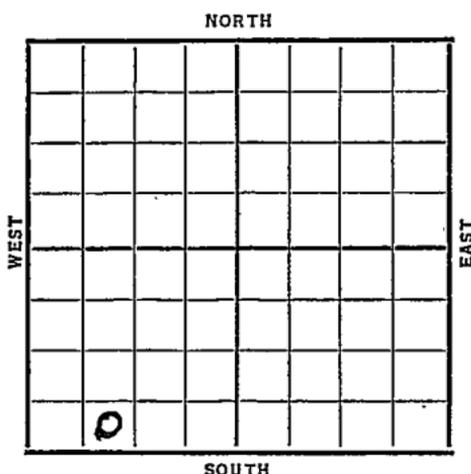

Date	REPORT
1937	
9/1	S. H.
9/10	13" @ 243'. Drlg. 2550'.
9/17	" " " " "
9/24	Chat 3283'. 7" @ 3284'. WOC.
10/2	T.D. 3369'. 3000 acid.
10/6	7" @ 3284'.
	Chat 3283'.
	T.D. 3369'.
	3000 acid.
	Pot. 470 bbls.
	COMPLETED

Harvey KANSAS

Map No. 39 Sec. 30 Twp. 23 R. 3WWell No. 3-NorrisCarl Hipple Company

Contractor

FIRST REPORT

SECTION PLAT

110 Ft. from N. Line330 Ft. from S. Line3 Ft. from E. Line990 Ft. from W. Line

o			

Location _____

Rig up _____

Drilling and Remarks:

S.H.

RECORD

Cased _____ in., _____ ft.

Sand _____

Gas _____

Oil _____

Total Depth _____

PRODUCTION

1st 24 hrs. Nat. _____

1st 24 hrs. after shot _____

Gas _____ Cu. Ft.

Dry Hole _____

Abandoned _____

Date

SEP 1 1937 19

H. D. Hatfield Scout

Map No. _____ Sec. 30 Twp. 23 R. 3W

Well No. 3 Norris

Carl Hipple Company

Contractor

COMPLETED

SECTION PLAT

SE SW SW

_____ Ft. from N. Line

330 Ft. from S. Line

_____ Ft. from E. Line

990 Ft. from W. Line

0

Location _____

Rig up _____

Drilling and Remarks:

3000 Acid

POT-470

RECORD

Cased 7 in. 3284 ft.

Sand Chat-3283

Gas _____

Oil _____

Total Depth 3369

PRODUCTION

1st 24 hrs. Nat. _____

1st 24 hrs. after shot _____

Gas _____ Cu. Ft.

Dry Hole _____

Abandoned _____

Date

OCT - 6 1937 19

H. D. Hatfield Scout