
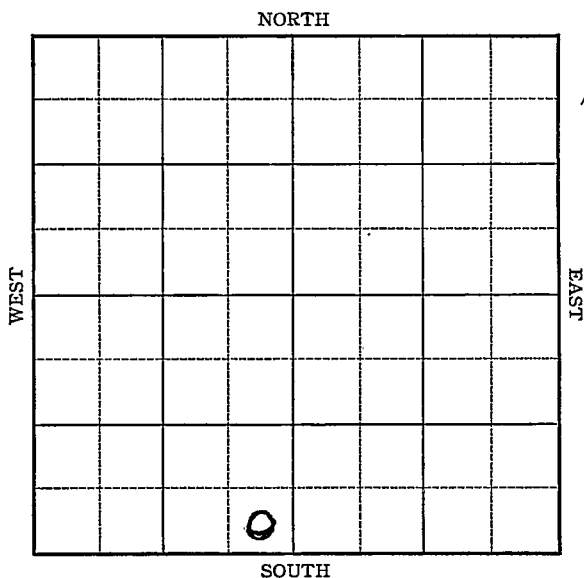


Harvey

Section 30 Township 23 Range 3-WWell No. 3 - Schray, Jr.Company Olson Drlg.

Sec. 30 Twp. 23 R. 3-WWell No. #3 Schrag, Jr. FarmOlson Drdg. Company Ft. from N. Line270 Ft. from S. Line330 Ft. from E. Line Ft. from W. Line

Elev. 1456

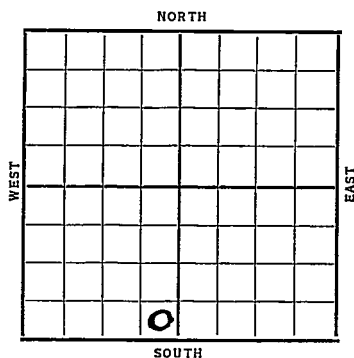

Date	REPORT
1937	
8/4	Location
8/13	R. U. R.
8/20	13" @ 250'. Drlg. 1250'.
8/28	10" @ 560'. T.D. 2458'. WOC.
9/3	Drlg. 3154'.
9/10	Chat 3267'. 6" @ 3282'.
	T.D. 3360'.
	Made 2 small flows oil.
9/15	6" @ 3282'
	Chat 3267'
	TD 3360'
	2000 acid
	Pot 1065
	Flow
	COMPLETED

Harvey **KANSAS**Map No. 39 Sec. 30 Twp. 23 R. 5WWell No. 3 - Schrag, Jr.Olson Drilling Company

Contractor

FIRST REPORT**SECTION PLAT**

	0		

_____ Ft. from N. Line

270 Ft. from S. Line330 Ft. from E. Line

_____ Ft. from W. Line

Location ✓

Rig up _____

Drilling and Remarks:

RECORD

Cased _____ in., _____ ft.

Sand _____

Gas _____

Oil _____

Total Depth _____

PRODUCTION

1st 24 hrs. Nat. _____

1st 24 hrs. after shot _____

Gas _____ Cu. Ft.

Dry Hole _____

Abandoned _____

Date

AUG 4 - 1931

19

H. D. Hatfield

Scout

Harvey KANSAS

Map No. 34 Sec. 30 Twp. 23 R. 3WWell No. 5-Schrag, Jr.Elson Drey Company

Contractor

COMPLETED

SECTION PLAT

	0		

_____ Ft. from N. Line

270 Ft. from S. Line330 Ft. from E. Line

_____ Ft. from W. Line

Location _____

Rig up _____

Drilling and Remarks:

2000 acidPat-1065flow

RECORD

Cased 6 in., 3282 ft.Sand Chat 3267

Gas _____

Oil _____

Total Depth 3360

PRODUCTION

1st 24 hrs. Nat. _____

1st 24 hrs. after shot _____

Gas _____ Cu. Ft.

Dry Hole _____

Abandoned _____

Date

SEP 15 1937

19

H. D. Hatfield

Scout