


Harvey

KANSAS

Section 30 Township 23 Range 3-W


Well No. 4 - Schrog, Jr.

Company Olson Oil

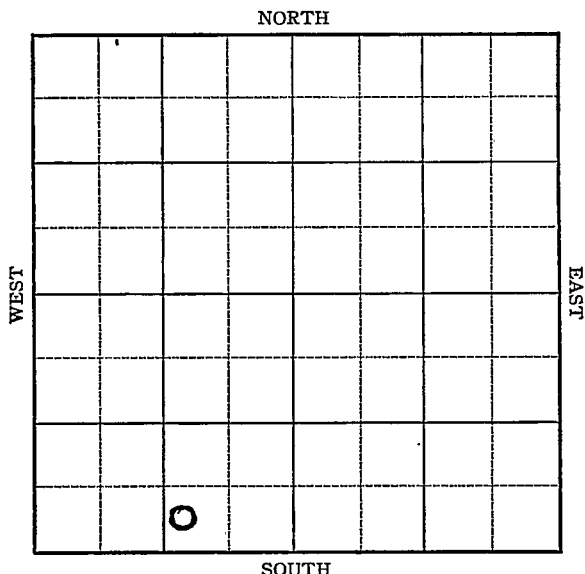

Sec. 30 Twp. 23 R. 3-WWell No. #4 Schrag Jr. FarmOlson Oil Company Ft. from N. Line330 Ft. from S. Line1020 Ft. from E. Line Ft. from W. Line

Elev. 1457

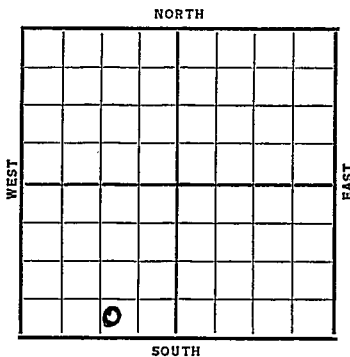

Date	REPORT
1937	
9/8	Cellar.
9/17	Mat.
9/24	12" @ 262'. Drlg. 309'.
10/2	Drlg. 2340'.
10/8	Drlg. 3088'.
10/15	" "
10/22	Chat 3274'. 7" @ 3291'.
	T.D. 3360'. Small flow.
	1000 acid.
10/27	7" @ 3291'.
	Chat 3274'.
	T.D. 3360'.
	1000 acid.
	Potential 1065 bbls.
	COMPLETED

Form 26 *Harvey*

KANSAS

Map No. 39 Sec. 30 Twp. 23 R. 3W

Well No. 4-Schroy Jr

Olsen Oil Company

Contractor

FIRST REPORT

_____ Ft. from N. Line

330 Ft. from S. Line

1020 Ft. from E. Line

_____ Ft. from W. Line

SECTION PLAT

	0		

Location _____

Rig up _____

Drilling and Remarks:

cellar

RECORD

Cased _____ in., _____ ft.

Sand _____

Gas _____

Oil _____

Total Depth _____

PRODUCTION

1st 24 hrs. Nat. _____

1st 24 hrs. after shot _____

Gas _____ Cu. Ft.

Dry Hole _____

Abandoned _____

Date

SEP 8 1937

H. D. Hatfield Scout

KANSAS

Harvey

Map No. 39 Sec. 30 Twp. 23 R. 3WWell No. 4 Schrag JrOlson Oil Company

Contractor

COMPLETED
SW SE SW

SECTION PLAT

	0		

 Ft. from N. Line330 Ft. from S. Line1020 Ft. from E. Line Ft. from W. LineLocation Rig up

Drilling and Remarks:

1000 acidPOT-1065

RECORD

Cased 7 in. 3291 ft.Sand Chat 3274Gas Oil Total Depth 3360

PRODUCTION

1st 24 hrs. Nat. 1st 24 hrs. after shot Gas Cu. Ft.Dry Hole Abandoned

Date

OCT 27 1937₁₉

Scout

H. D. Hatfield