


Section 30 Township 23 Range 3-W

Well No. #3 Short

Company Skiles, Bennett & Hammond

NORTH Burrton Pool

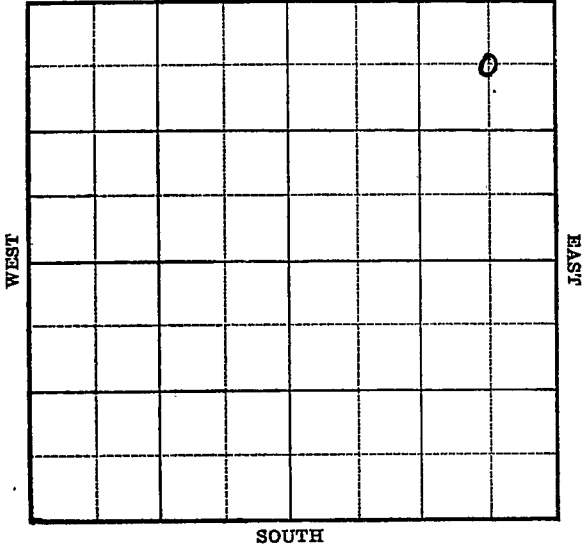

Harvey

Map No. 39 Sec. 30 Twp. 23 R. 3WWell No. 3 ShortSkiles, Bennett & Hammond
Company

(formerly Central Oil)

~~FIRST REPORT~~

Contractor

SECTION PLAT

C NE NE


660 Ft. from N. Line

_____ Ft. from S. Line

660 Ft. from E. Line

_____ Ft. from W. Line

BURRTON POOL

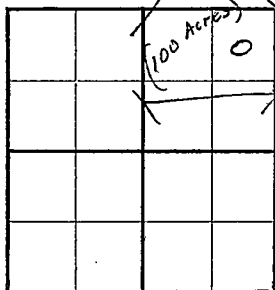

Location _____

Rig up _____

Drilling and Remarks:

10" - 195

Drig. 2100

RECORD

Cased _____ in., _____ ft.

Sand _____

Gas _____

Oil _____

Total Depth _____

PRODUCTION

1st 24 hrs. Nat. _____

1st 24 hrs. after shot _____

Gas _____ Cu. Ft.

Dry Hole _____

Abandoned _____

Date

APR 19 1939

19

H. D. Hatfield

Scout

Map No. 39 Sec. 30 Twp. 23 R. 3WWell No. 3 ShortSkiles, Bennett & Hammond

Company

(formerly Central Oil)

Contractor

COMPLETED

C NE NE

660 Ft. from N. Line

_____ Ft. from S. Line

660 Ft. from E. Line

_____ Ft. from W. Line

SECTION PLAT

			0

BURRTON POOL

Location _____

Rig up _____

Drilling and Remarks:

*Chat 3258**5" @ 3328**Pay 3349-60**2500 acid**P. Y.**Pump & flow 811*

RECORD

Cased _____ in., _____ ft.

Sand _____

Gas _____

Oil _____

Total Depth 3361

PRODUCTION

1st 24 hrs. Nat. _____

1st 24 hrs. after shot _____

Gas _____ Cu. Ft.

Dry Hole _____

Abandoned _____

Date

MAY 17 1939 19

S. I. LEWIS Scout