

FORM M41

DRILLING WELL COMPLETION REPORT

Well No. Two Farm Name Opal Hartnett

Date completed January 17, 1945

Description SEC. 36-239-10W

County Reno, State Kansas

Initial production 540 bbls. Total depth 5695 feet

Initial volume _____ cu. ft. _____ lbs. rock pressure

Pipe Line Company _____

Gas Company _____

Remarks: Pumping test


Ag. Sec.

3 Accounting Dept.
 Rental Dept.
 ✓ Scouting Dept.
 Engineering Dept.
 Legal Dept.
 Lease Inventory Man
 Tax Dept.
 Geological
 File
J. M. Linehan
W. G. Barnock

LOCATION NOTICE

TULSA, OKLA. December 7, 1944WELL NO. 2 ON Coal Hartnett FARM

WILL BE AS FOLLOWS:

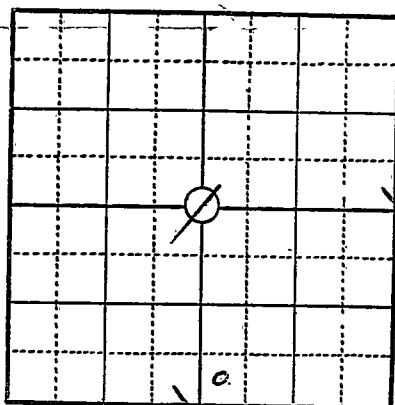

FEET FROM NORTH LINE

FEET FROM EAST LINE

330

FEET FROM SOUTH LINE

330

FEET FROM WEST LINE

IN 351 SEC. 30 TWP. 233 RANGE 107Now COUNTY, STATE OF KansasREMARKS: Floyd Snyder, District SuperintendentS. K. Holmchen, District ForemanSIGNED allica

COPIES TO

DISTRICT SUPT.

ACCOUNTING DEPT.

RENTAL DEPT.

✓ SCOUTING DEPT.

ENGINEERING DEPT.

LEGAL DEPT.

LEASE INVENTORY

CLAIM DEPT.

TAX DEPT.

GEOLOGICAL DEPT.

FILE

PURCHASING DEPT.

PIPE LINE DEPT.

PRIORITIES DEPT.

Small Map L Reid
 Wall Map L Reid

MID-CONTINENT PETROLEUM CORPORATION

OPAL HARTNETT WELL NO. 2
SW/4 SW/4 SE/4, Section 30-23-10W
Beno County, Kansas

CASING RECORD:

10 3/4"
7 "

226*11"
3667'

FORMATION	TOP	BOTTOM	
Surface Clay and sand	0	110	
Sand	110	150	
Shale	150	190	
Sand	190	210	
Shale and shells	210	240	
Shale	240	300	
Red bed	300	360	
Shale & shells	360	470	
Sand & shale	470	475	
Shale and shells	475	1450	
Lime and shale	1450	1570	
Shale	1570	1595	
Lime and shale	1595	1635	
Shale and shells	1635	1700	
Lime	1700	2070	
Broken Lime	2070	2150	
Shale	2150	2230	
Shale and shells	2230	2710	
Lime and shale	2710	2795	
Shale	2795	2800	
Lime	2800	3170	
Lime and shale	3170	3240	
Lime	3240	3280	
Broken Lime	3280	3290	
Lime and shale	3290	3320	
Lime	3320	3395	
Sandy lime	3395	3400	
Lime and shale	3400	3405	
Lime	3405	3651	
Sand (Misner)	3651	3653	No oil
Lime (Viola)	3653	3674	
Lime (Viola)	3674	3675	No oil
Lime (Viola)	3675	3677	
Lime (Viola)	3677	3679	Oil smell
Lime (Viola) with green shale	3679	3684	No porosity
Lime	3684	3688	Slight porosity
Lime, hard and cherty	3688	3690	Slight increase in gas
Lime very hard	3690	3691	Increase in gas
Lime very hard	3691	3692	Increase in oil
Lime softer	3692	3693	2300* of oil in hole in 10 hours
TOTAL DEPTH		3693	

COMMENCED: 12-15-44

COMPLETED: 1-10-45

POTENTIAL: 340 Barrels

ELEVATION: 1801 feet

Form M-846

REPORT OF PRODUCING WELL ABANDONED

Well No. 2 Farm Name Opal Hartnett

Description SE/4 Sec. 30-23S-10W

County Reno State Kansas

Date Plugging Completed March 24, 1950

Last Well on Lease

Accounting Dept.
Rental Dept.
Scouting Dept. —
Engineering Dept.
Legal Dept.
Lease Inventory Man
Tax Dept.
Purchasing Dept.
File

Pipe Line Dept.
Income Tax Dept.

A. H. Pierce

A. H. Pierce