

KANSAS

Pawnee County

FORM 51 5M PETROL

Section 30 Township 23 Range 15W

Well No. 1 Benson

Company Stanolind & Skelly

NORTH

		0					

SOUTH

WEST

EAST

3

KANSAS

Pawnee

Sec. 30 Twp. 23 R. 15W

Well No. 1 Benson Farm

Stanölinö & Skelly Company

Wildcat

330

Ft. from N. Line

Ft. from S. Line

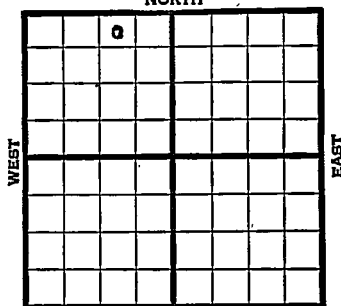
990

Ft. from E. Line

Ft. from W. Line

NW NE NW Elev. 2039

NORTH



1945

R E P O R T

6/13	Location
6/21	13" @ 383
	Anhy 975
	Drlg 1742
6/28	Drlg. 2350
7/3	Lans 3628
	Drlg. 3875' SO
7/11	Arb. 4065
	Drlg. 4093' SSO
7/19	TD 4165
	5" @ 4165' RUST
7/26	40 shots 4140-4150
	1000 acid.
	14 $\frac{1}{2}$ M Gas.
8/1	120 shots 4100-4140 3000 acid.
	12-3/4 M Gas
8/8	Plug 4077
	48 shots 3853-3869 500 acid.
	Swab 2 oil per hr.
	60 shots 3798-3807 & 3821-31
	22.8 grav.
8/15	1000 acid. Swab 25 oil per hr. No W
	60 shots 3748-3760 1000 acid
	Swab 9 oil per hr
	76 shots 3703-3726 CO
8/22	2000 acid.
	Swab 19 oil per hr. 23.2 Grav.
	18 shots 3622-3628 2000 acid.
8/29	" " " " "

OVER

2. 2. 2.

9/5 PB 4049
Pump 10 fluid per hr. 10% W 34% B.S.
9/12
9/19 Lans. 3628
Arb. 4065
5" @ 4165
Perf. Lans
TD 4165'
Pump 357 oil plus 70 W
Grav. 27.0
Had 100,000,000 Gas in Arb.

COMPLETED

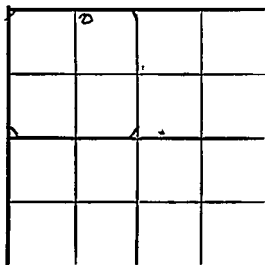
Kansas Pool Name WildcatMap No. 73 Sec. 30 Twp. 23 R. 15WWell No. 1 BensonStanolind & Skelly Company

FIRST REPORT

Contractor

NW NE NW

SECTION PLAT

330 Ft. from N. Line Ft. from S. Line990 Ft. from E. Line Ft. from W. LinePawnee CountyLocation XRig up

Drilling and Remarks:

RECORD

Cased in., ft.Sand Gas Oil Total Depth

PRODUCTION

1st 24 hrs. Nat. 1st 24 hrs. after shot Gas Cu. Ft.Dry Hole Abandoned

Date

JUN 13 1945 19 S. J. LEWIS Scout

Pool Name Benson

KANSAS

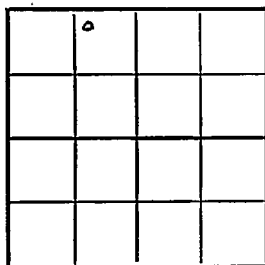
Kansas

Map No. 83 Sec. 30 Twp. 23 R. 15WWell No. 1 BensonStanolind & Skelly Company

COMPLETED

Contractor

NW NE NW

E 12039
SECTION PLAT330 Ft. from N. Line Ft. from S. Line990 Ft. from E. Line Ft. from W. Line

Pawnee County

Location Rig up

Drilling and Remarks:

Lease 3628.Ord 4065.5" C 4/6 5"Perf Lease.Pump 357 ac + 70W
27282had 100,000,000 galin Ord

Date

RECORD

Cased in., ft.Sand Gas Oil Total Depth 4165.

PRODUCTION

1st 24 hrs. Nat. 1st 24 hrs. after shot Gas Cu. Ft.Dry Hole Abandoned

SEP 19 1945

19

S. I. LEWIS

Scout