


Section 30 Township 23 Range 15 W

Well No. # 1 Garvin

Company M. B. Armer

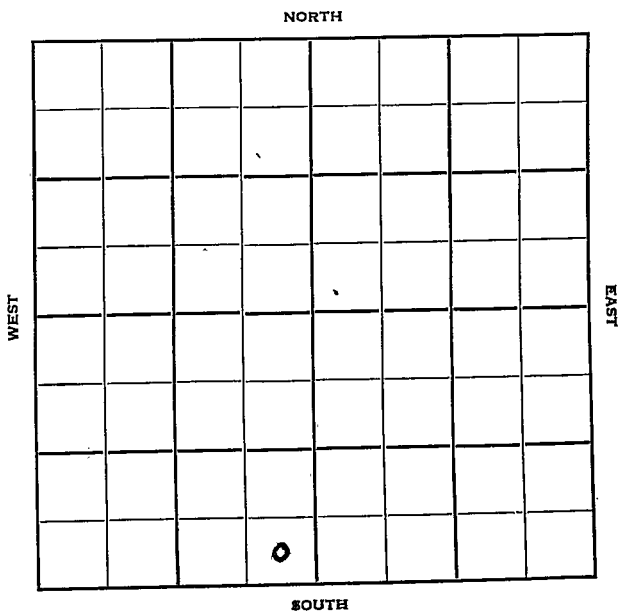

14

Sec. 30 Twp. 23 R. 15W

Well No. #1 Garvin Farm

M. B. Armer Company

Armer - Contr. Contractor


Semi-Wildcat

         Ft. from N. Line

330' Ft. from S. Line

330' Ft. from E. Line

         Ft. from W. Line

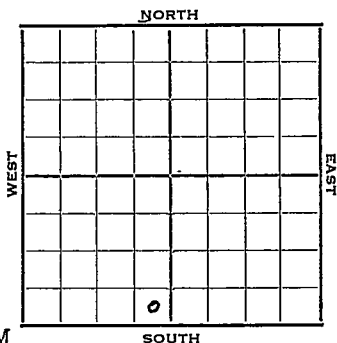

SE SE SW

Lion & Skelly DHM  
Continental & Stano. DHM

1952 **Elev. 2045'** REPORT

4/30 Spud 4-29-52  
8" @ 366  
WOC

5/7 Drlg. 3405'

5/14 Heeb. 3485 Br Li 3623  
Lans. KC 3631  
DST 3690-3707, 1½ hr. 60' VSOCM  
180' wtr. 1005#  
DST 3750-65, 1 hr. 100' OCM 360' oil  
60' wtr. 1016#  
DST 3796-3844, 1 hr. 150' OCM 120'  
HOCM 985# 15"  
V. 4002 Simp. 4037 Arb. 4072  
DST 4077-4142, ¾ hr. 6 m cu ft gas.  
5" @ ? TD

5/21 RTD 4200' 5" @ 4200' CO 4165  
12/3754-58 S/ 1½ Bfph 50% oil  
500 A HFW sq. off

5/28 Did not sq wtr declined S/28 BOPH  
for 6 hrs. POP

6/11 P/ 10 Boph

6/18 NR  
6/25 "

7/2 NR

7/9 NR

7/17 NR

OVER


1952

7/23 , Spud 4-29-52  
0 Oil Well TD 4200'  
8" @ 366'  
Heeb. 3485 Br Li 3623  
Lans. 3631  
DST 3690-3707 open 1½ hr. rec. 60'  
vsocm 180' wtr. 1005#  
DST 3750-65 open 1 hr. rec. 100'  
ocm 360' oil 60' wtr. 1016#  
DST 3796-3844 open 1 hr. rec. 150'  
ocm. 120' hocm 985#  
Viola 4002 Simp. 4037  
Arb. 4072  
DST 4077-4142 open 3/4 hr. 6 mcfg  
5" @ 4200 TD 4200 CO to 4165  
12/ 3754-58 S/ 1½ bfph 50% oil  
500 A HFW sq off S/ 28 boph  
P/ 10 boph  
Comp. 401 bopd 12% wtr.

**COMPLETED**



County Pawnee State Kansas  
 Sec. 30 (Blk. 23 (Sur. 15W Map No.  
 Twp.) Rge.)  
 Operator M. B. Armer  
 Well No. 1 Farm Garvin  
 Elev. 2045 Location SE SE SW

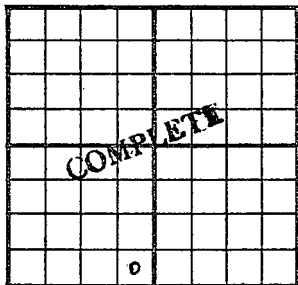

330 Ft. From S Line SW  
330 Ft. From E Line Quarter  
 Ist. Report  
 Completion JUL 23 1952  
 Remarks  
Armer - Contr.  
 Spudding Date 4-29-52

Drlg. Data Oil well TD 4200  
8" @ 366 Heeb. 3485 Br. lime 3623  
Lans. 3631 DST 3690-3707 open 1½ hr.  
Rec. 60' vsocm 180' water 1005#  
DST 3750-65 open 1 hr. Rec. 100' ocm  
360' oil 60' water 1016# DST 3796-  
3844 open 1 hr. Rec. 150' ocm  
120' hocm 985# Viola 4002 Simp. 4037  
Arb. 4072 DST 4077-4142 open ¾ hr.  
6 mcfg 5" @ 4200 TD 4200 CO to 4165  
12/ 3754-58 S/ 1½ bph 50% oil 500 A  
FWW sq off S/ 28 boph P/ 10 boph  
Comp. 401 bopd 12% water

J. G. McGEHEE