


Section 30 Township 23W Range 15W

Well No. 5 Garvin

Company M. B. Armer

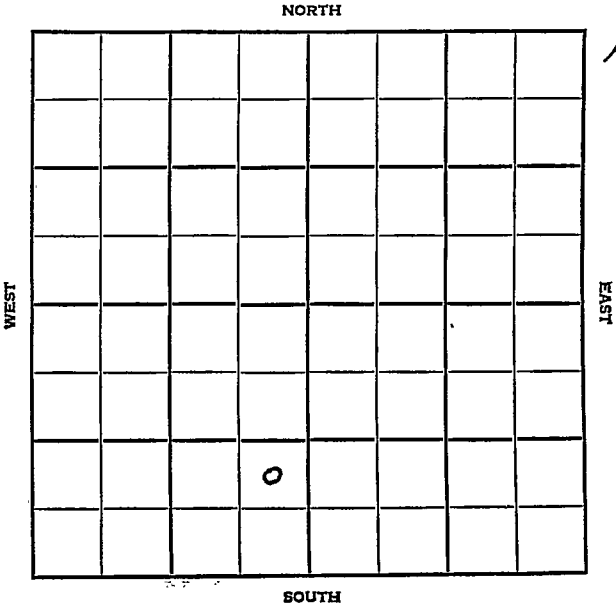

14

# Pawnee KANSAS

|      |      |     |
|------|------|-----|
| SEC. | TWP. | R.  |
| 30   | 23   | 15W |

WELL NO.

5 Garvin

FARM

COMPANY

M. B. Armer

CONTRACTOR

Armer

, Benson Pool


\_\_\_\_\_ Ft. from N. Line

990 \_\_\_\_\_ Ft. from S. Line

330 \_\_\_\_\_ Ft. from E. Line

\_\_\_\_\_ Ft. from W. Line

NE SE SW

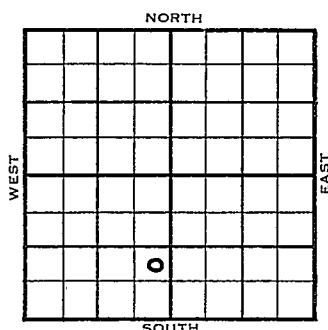

1954

ELEVATION

2048

REPORT

6/15

Spdg 6-3-54

KC 3604

Drlg. 3766

6/23

RTD 3991 5" @ 3991

7/7

Spud 6-3-54 Oil well TD 3991

8" @ 299 Heeb 3465 Tor. 3485

Doug. 3501 Br. lime 3584 Lans 3603

DST 3598-3620 open  $\frac{1}{2}$  hr rec 30' GCM

1225#

DST 3663-89 open 1 hr rec 1000' OCW

1025#

DST 3750-66 open 1 hr rec 3550' oil

1105#

DST 3791-3816 open 1 hr rec 30' OCM

0# B KC 3827 Cong. 3941

Simp. 3969 TD 3991 5" @ 3991

48/3751-59 1000 A S/22 $\frac{1}{2}$  BOPH 12 hr.

Comp. 2643 BOPD

**COMPLETED**

J. G. McGEHEE

County Pawnee State Kansas  
 Sec. 30 (Blk.) 23 (Sur.) 15W Map No.  
 Operator M. B. Armer  
 Well No. 5 Farm Garvin  
 Elev. 2048 Location NE SE SW

|  |  |  |  |  |  |
|--|--|--|--|--|--|
|  |  |  |  |  |  |
|  |  |  |  |  |  |
COMPLETE

990 Ft. From S Line SW  
330 Ft. From E Line Quarter  
 1st. Report  
 Completion JUL 7 1954  
 Remarks Benson Pool  
Armer - Contr.  
 Spudding Date 6-3-54

Drilg. Data Oil well TD 3991  
8" @ 299 Heeb. 3465 Tor. 3485  
Doug. 3501 Br. lime 3584 Lans. 3603  
DST 3598-3620 open  $\frac{1}{2}$  hr. Rec. 30' gcm  
1225# DST 3663-89 open 1 hr. Rec.  
1000' ocw 1025# DST 3750-66 open 1 hr.  
Rec. 3550' oil 1105# DST 3791-3816  
open 1 hr. Rec. 30' ocm 0# B KC 3827  
Cong. 3941 Simp. 3969 TD 3991  
5" @ 3991 48/ 3751-59 1000 A  
S/ 22 $\frac{1}{2}$  boph 12 hr. Comp. 2643 bopd

J. G. McGENEE