


Section 30 Township 23 Range 24 W

Well No. # 1 Wyott

Company I. W. Seigel et al

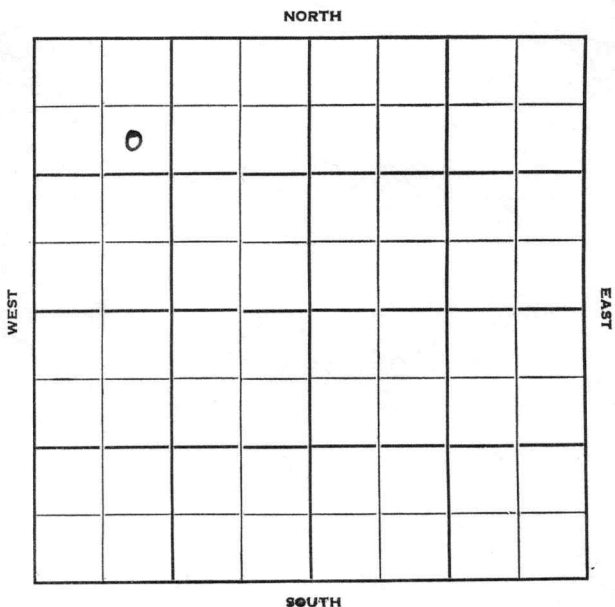

Hodgeman **KANSAS**

Sec. 30 Twp. 23 R. 24W

Well No. #1 Wyott Farm

I. W. Seigel et al Company

Armer - Contr. Contractor


990' Ft. from N. Line

_____ Ft. from S. Line

_____ Ft. from E. Line

990' Ft. from W. Line

SE NW NW

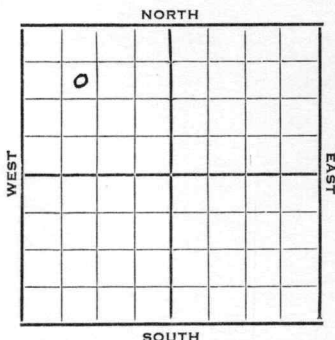


1951 Elev. 2509' REPORT

12/19 Spud 12-16-51
8" @ 175'

1952
1/9 Spud 12-16-51
D&A TD 4798'
8" @ 175'
Heeb. 4008
Lans. 4076
Miss. 4740
Dol. 4792
TD 4798
D&A

Tor. 4034
Cong. 4730
Limestone 4761

ABANDONED

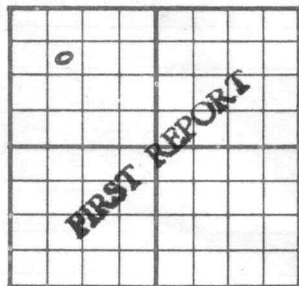County Hodgeman State KansasSec. 30 (Blk. 23 (Sur. 24W (Twp.) Rge.) Map No.Operator I. W. Seigel et al.Well No. 1 Farm WyottElev. Location SE NW NW990 Ft. From N Line NW990 Ft. From W Line Quarter1st. Report DEC 1 9 1951


Completion

Remarks

Armer - Contr.Spudding Date 12-16-51

Drlg. Data

8" @ 175'J. E. TYRA

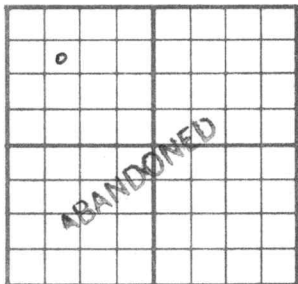County Hodgeman State KansasSec. 30 (Blk. 23) (Sur. 24W) Map No.Operator I. W. Seigel et al.Well No. 1 Farm WyottElev. 2509 Location SE NW NW990 Ft. From N Line NW990 Ft. From W Line Quarter

1st. Report

Completion JAN 9 1952

Remarks

Armer - Contr.Spudding Date 12-16-51Drlg. Data D & A TD 47988" @ 175 Heeb. 4008 Tor. 4034Lans. 4076 Cong. 4730 Miss. 4740Limestone 4761 Dol. 4792 TD 4798D & A

J. E. TYRA