


Section 30 Township 23 Range 34W

Well No. #1 Danler

Company Champlin Ref.

Hugoton Pool

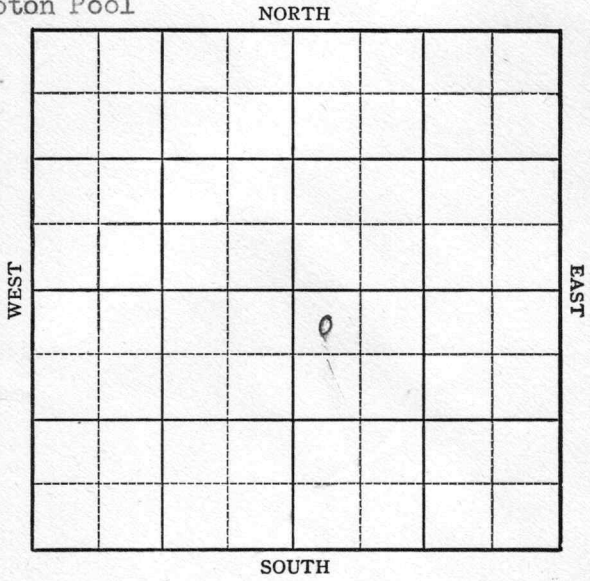

Sec. 30 Twp. 23 R. _____

Well No. #1 Danler Farm

Champlin Ref. Company


Hugoton Pool (Champlin Ref., Contr.)

330' Ft. from N. Line

_____ Ft. from S. Line

_____ Ft. from E. Line

330' Ft. from W. Line

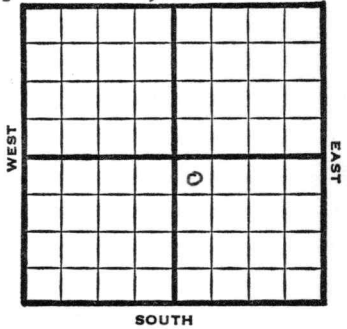

NW SE

SOUTH

1949 Elev. 2979' REPORT

12/7 Drlg. 550'

12/14 8" @ 660'
TD 2664'

12/21 "

12/28 "

1950
1/25 8" @ 660'
5" @ 2660'
Heeb. 2464'
Kv 2494'
Sin 2565'
Tor 2608'
TD 2664'

Perf 20/2559-63
" 20/2568-73
" 90/2515-30
" 90/2496-2511
" 24/2634-38

Used 45,000 acid
Flowed 7,749,000 gas pr day

COMPLETED

Map No. _____ Sec. 30 Twp. 23 R. 34W

Well No. 1 Danler

Champlin Ref. Company _____

Champlin Ref. Contractor _____

NW SE

FIRST REPORT
SECTION PLAT

330 Ft. from N. Line

_____ Ft. from S. Line

_____ Ft. from E. Line

330 Ft. from W. Line

		o	

Finney County

Location _____

Rig up _____

Drilling and Remarks:

drlg. 550

RECORD

Cased _____ in., _____ ft.

Sand _____

Gas _____

Oil _____

Total Depth _____

PRODUCTION

1st 24 hrs. Nat. _____

1st 24 hrs. after shot _____

Gas _____ Cu. Ft.

Dry Hole _____

Abandoned _____

Date

DEC 7 1949 19 _____

S. J. LEWIS

Scout

Kansas

Map No. _____ Sec. 30 Twp. 23 R. 34W

Well No. 1 Danler

_____ Champlin Ref. _____ Company

_____ Contractor

NW SE

EI. 2979
SECTION PLAT

330 Ft. from N. Line

_____ Ft. from S. Line

_____ Ft. from E. Line

330 Ft. from W. Line

COMPLETE		
	o	

Finney County

Location _____

Rig up _____

Drilling and Remarks:

8" @ 660'
5" @ 2660

Net 2464

Kr. 2494

Win 2565

Jor 2608

(over)

RECORD

Cased _____ in., _____ ft.

Sand _____

Gas _____

Oil _____

Total Depth 2664

PRODUCTION

1st 24 hrs. Nat. _____

1st 24 hrs. after shot _____

Gas _____ Cu. Ft.

Dry Hole _____

Abandoned _____

Date

JAN 25 1950

J. E. TYRA

Per F. 20/2559-63

" 20/2568-73

" 90/2515-30

" 90/2496-2511

" 24/2634-38

used 45000 acid

Flawed

7749000' gas

per day

d

- Scout Cards
- Land Small Map
- Land Wall Map
- Tracings
- France Map
- Pierce Map
- Misc.

JAN 30 1950

Date