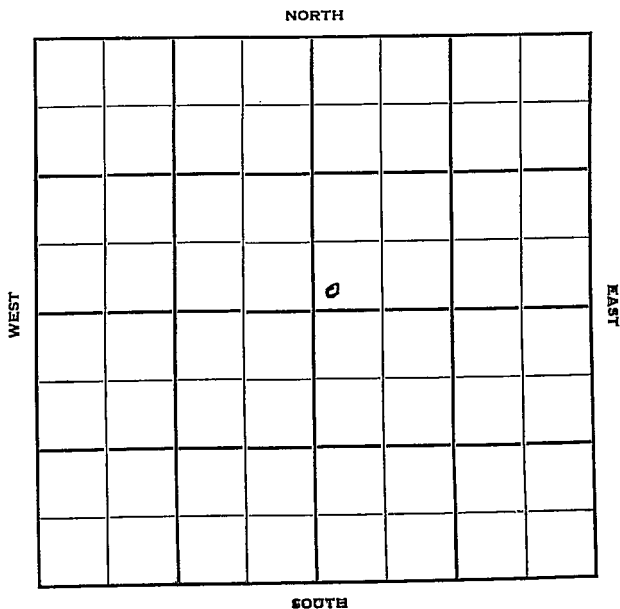


Section 30 Township 23 Range 36WWell No. #1 Stallman "F"Company Stanolind

Kearny

KANSAS

Sec. 30 Twp. 23 R. 36 W

Well No. # 1 Stallman "F" Farm ✓

Stanolind Oil & Gas Company

Contractor

Hugoton Pool


Ft. from N. Line

150 Ft. from S. Line

Ft. from E. Line

150 Ft. from W. Line

SW NE

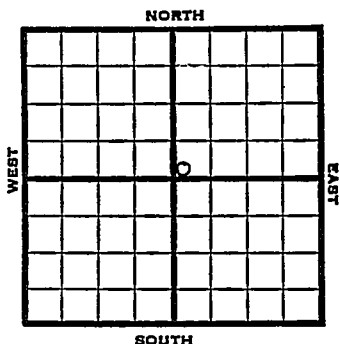

1951

Elev. 3233' REPORT

10/3

Location

11/21

Spud 10-1-51

Gas Well TD 2762

10" @ 765

Her. 2571 Win. 2633

Ft. Riley 2686

7" @ 2584 TD 2762

71 qt/ 2728-51 74 qt/ 2686-2706

56 qt / 2626-50 65 qt/ 2594-2620

CO to 2762' 24/ 2570-74

42/ 2577-84 150000A

Comp. 3,407,000 gas

COMPLETED

County **Kearny** State **Kansas**
 Sec. **30** (Blk. Twp.) **23** (Sur. Rge.) **36W** Map No.
 Operator **Stanolind**
 Well No. **1** Farm **Stallman "F"**
 Elev. Location **SW NE**

FIRST REPORT									

150 Ft. From **S** Line **NE**
150 Ft. From **W** Line Quarter
 1st. Report **OCT 3 1951**
 Completion
 Remarks
 Spudding Date

Drlg. Data

Hugoton Pool

Location

J. E. TYRA

County Kearny State Kansas

Sec. 30 (Blk. Twp.) 2 3 (Sur. Rge.) 36W Map No.

Operator Stanolind

Well No. 1 Farm Stallman "F"

Elev. 3233 Location SW NE

0

COMPLETE

150' Ft. From S Line NE

150 Ft. From W Line Quarter

1st. Report _____

Completion NOV 21 1951

Remarks	Hugoton Pool
---------	--------------

Spudding Date 10-1-51

Drig. Data Gas well TD 2762

10" @ 765 Her. 2571 Win. 2633

Fr. Riley 2686 7" @ 2584 TD 2762

71 qt/ 2728-51 74 qt/ 2686-2706

56 qt/ 2626-50 65 qt/ 2594-2620 CO to 2762

24/ 2570-74 42/ 2577-84 15000 A

Comp. 3,407,000 gas