

STATE CORPORATION COMMISSION OF KANSAS  
OIL & GAS CONSERVATION DIVISION  
WELL COMPLETION OR RECOMPLETION FORM  
ACO-1 WELL HISTORY  
DESCRIPTION OF WELL AND LEASE

Operator: License # 5364  
Name Beren Corporation  
Address 970 Fourth Financial Center  
Wichita, KS 67202  
City/State/Zip

Purchaser Koch

Operator Contact Person Evan C. Mayhew  
Phone (316) 265-3311

Contractor: License # 5147  
Name BEREDCO, Inc.

Wellsite Geologist Kenneth Johnson  
Phone

Designate Type of Completion

New Well     Re-Entry     Workover  
 Oil     SWD     Temp Abd  
 Gas     Inj     Delayed Comp.  
 Dry     Other (Core, Water Supply etc.)

If OWWO: old well info as follows:

Operator  
Well Name  
Comp. Date ..... Old Total Depth

WELL HISTORY

Drilling Method:

Mud Rotary     Air Rotary     Cable

9-25-87    10-4-87    11-3-87  
Spud Date    Date Reached TD    Completion Date

4950'    4818'  
Total Depth    PBD

Amount of Surface Pipe Set and Cemented at 400' feet  
Multiple Stage Cementing Collar Used?  Yes     No

If yes, show depth set 2092' feet

If alternate 2 completion, cement circulated  
from 2092' feet depth to 450' SX cmt

Cement Company Name  
Invoice #

API NO. 15-055-20.723

County Finney

E/2 SE NE Sec. 12 Twp 23S Rge. 31  East  West

3300 Ft North from Southeast Corner of Section  
330 Ft West from Southeast Corner of Section  
(Note: Locate well in section plat below)


Lease Name HAAG ESTATE Well # 3

Field Name

Producing Formation Morrow

Elevation: Ground 2870' KB 2882'

Section Plat

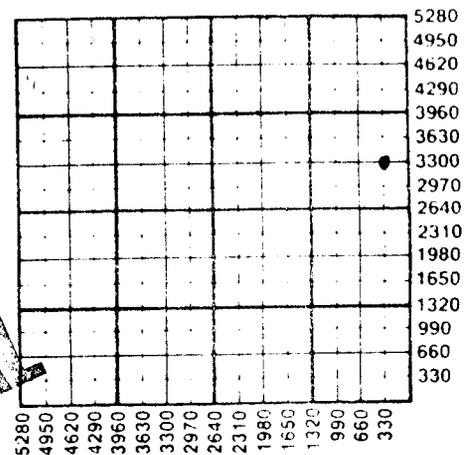

WATER SUPPLY INFORMATION

Disposition of Produced Water:  Disposal  
Docket # 88,702-C (C-15435)  Repressuring  
Mackey SWD

Questions on this portion of the ACO-1 call:

Water Resources Board (913) 296-3717

Source of Water: Carlile Water  
Division of Water Resources Permit # 6489

Groundwater ..... Ft North from Southeast Corner  
(Well) ..... Ft West from Southeast Corner of  
Sec    Twp    Rge     East     West

Surface Water ..... Ft North from Southeast Corner  
(Stream, pond etc) ..... Ft West from Southeast Corner  
Sec    Twp    Rge     East     West

Other (explain) .....  
(purchased from city, R.W.D. #)

INSTRUCTIONS: This form shall be completed in duplicate and filed with the Kansas Corporation Commission, 200 Colorado Derby Building, Wichita, Kansas 67202, within 90 days after completion or recompletion of any well. Rule 82-3-130 and 82-3-107 apply.

Information on side two of this form will be held confidential for a period of 12 months if requested in writing and submitted with the form. See rule 82-3-107 for confidentiality in excess of 12 months.

One copy of all wireline logs and drillers time log shall be attached with this form. Submit CP-4 form with all plugged wells. Submit CP-111 form with all temporarily abandoned wells.